


Section 16 Township 25 Range 35W

Well No. #1 Tate Est. "B"

Company Magnolia
Hugoton Pool

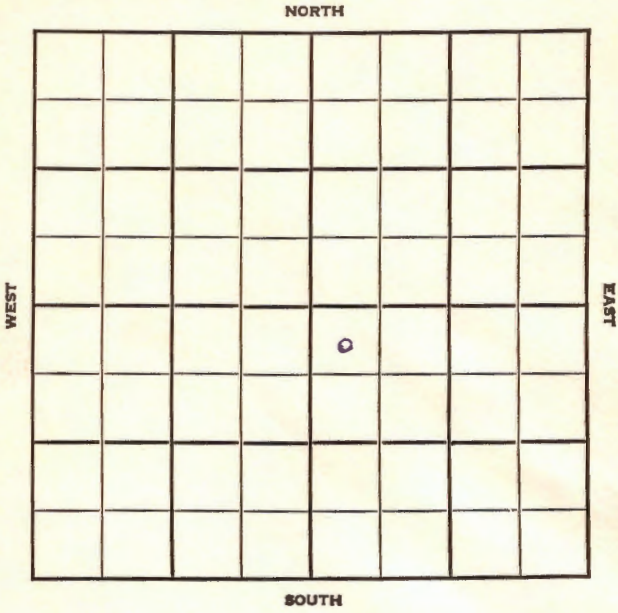

KANSAS

Kearny

Sec. 16 Twp. 25 R. 35W


Well No. #1 Tate Est. "B" Farm

Magnolia Company

Hugoton

NORTH

330' Ft. from N. Line

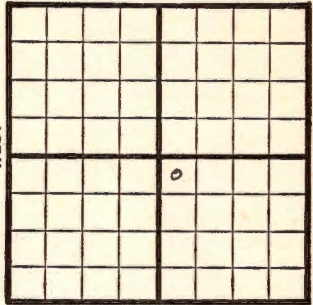

_____ Ft. from S. Line

_____ Ft. from E. Line

330' Ft. from W. Line

NW SE

SOUTH

1948 **Elev. 2990'** REPORT

3/24 Location

3/31 "

4/7 "

4/14 "

4/21 "

4/28 RUR

5/5 10" @ 298'
Drlg. 2370'

5/12 TD 2709'
7" @ 2708'

5/19 "

5/26 120 shots 2618-45' - 7000 acid
168 shots 2560-96' - 7000 acid
48 shots 2516-28' - 7000 acid
77 shots 2470-88' - 7000 acid
67 shots 2448-64'

6/1 7000 acid.

6/9 7" @ 2708'
Perf.
35000 acid
18,600,000 gas
375# R. Pr.
TD 2709'
Comp.

COMPLETED

Map No. _____ Sec. 16 Twp. 25 R. 35W

Well No. 1 Tate Est. "B"

Magnolia Company

FIRST REPORT

Contractor _____

NW SE

SECTION PLAT

330 Ft. from N. Line

_____ Ft. from S. Line

_____ Ft. from E. Line

330 Ft. from W. Line

		o	

Kearny County

Location X

Rig up _____

Drilling and Remarks:

RECORD

Cased _____ in., _____ ft.

Sand _____

Gas _____

Oil _____

Total Depth _____

PRODUCTION

1st 24 hrs. Nat. _____

1st 24 hrs. after shot _____

Gas _____ Cu. Ft.

Dry Hole _____

Abandoned _____

Date

MAR 24 1948 19

S. J. LEWIS Scout

Map No. _____ Sec. 16 Twp. 25 R. 35W

Well No. 1 Tate Est. "B"

Magnolia _____ Company

COMPLETE

Contractor

NW SE

E. 2990

SECTION PLAT

330 Ft. from N. Line

_____ Ft. from S. Line

_____ Ft. from E. Line

330 Ft. from W. Line

		0	

Kearny County

Location _____

Rig up _____

Drilling and Remarks:

7 "02708.

Ref.

35000 acid

18,600,000 gal

*SP25*P2*

RECORD

Cased _____ in., _____ ft.

Sand _____

Gas _____

Oil _____

Total Depth *2209*

PRODUCTION

1st 24 hrs. Nat. _____

1st 24 hrs. after shot _____

Gas _____ Cu. Ft.

Dry Hole _____

Abandoned _____

Date

JUN 9 1948 19

S. J. LEWIS Scout