

KANSAS


FORM 51 5M 6-46 PETROL

Kearny County

Section 8 Township 25 Range 35W

Well No. 12 Campbell

Company Fin-Ker

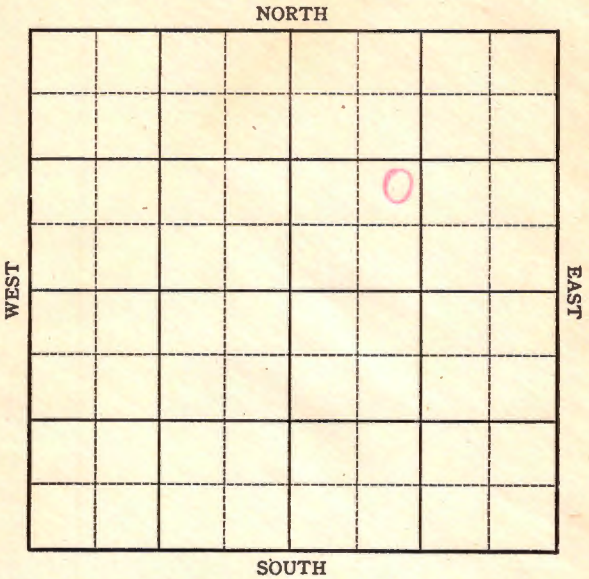

KANSAS

Sec. 8 Twp. 25 R. 35W

Well No. #12 Campbell Farm

Fin-Ker Company


Hugoton

Ft. from N. Line

1200 Ft. from S. Line

Ft. from E. Line

1295 Ft. from W. Line

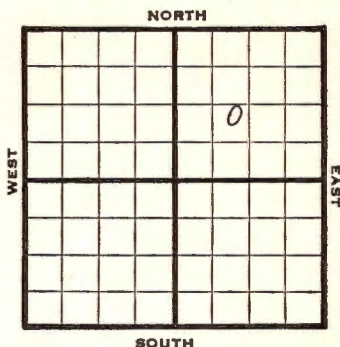

NE SW NE

1946 **3022** REPORT

8/8 Location
8/13 Drlg 530'
8/20 1560' Run csg
8/27 " "
9/4 10" @ 1490'
Drlg 1600'
9/10 7" @ 2726
TD 2734 RUST
9/18 " "
9/24 " "
10/1 " "
10/8 " "
10/15 " "
10/22 " "
10/29 " "
11/6 " "
11/12 " "
11/20 " "
11/27 45000 acid
12/3 " "
12/10 " "
12/18 7" @ 2726'
TD 2734'
Perf
38,004,000 Gas
45000 Acid

COMPLETED

KANSAS

Kansas Pool Name HugotonMap No. _____ Sec. 8 Twp. 25 R. 35WWell No. 12 CampbellFin-Ker

Company _____

FIRST REPORT

Contractor _____

NE SW NE

SECTION PLAT

		0	

_____ Ft. from N. Line

— 1200 Ft. from S. Line

_____ Ft. from E. Line

— 1295 Ft. from W. LineKearny County

RECORD

Location _____

Cased _____ in., _____ ft.

Rig up _____

Sand _____

Drilling and Remarks:

Gas _____

Oil _____

Total Depth _____

PRODUCTION

1st 24 hrs. Nat. _____

1st 24 hrs. after shot _____

Gas _____ Cu. Ft.

Dry Hole _____

Abandoned _____

Date

AUG 7 1946 19S. J. LEWIS Scout

Map No. _____ Sec. 8 Twp. 25 R. 35WWell No. 12 Campbell

Fin-Ker

Company _____

COMPLETED

Contractor _____

NE SW NE

*F18022***SECTION PLAT**

		o	

_____ Ft. from N. Line

1200 Ft. from S. Line

_____ Ft. from E. Line

1295 Ft. from W. Line

Kearny County

Location _____

Rig up _____

Drilling and Remarks:

*7" C2726**Prof.**35,000,000 Gas**45000 acid***RECORD**

Cased _____ in., _____ ft.

Sand _____

Gas _____

Oil _____

Total Depth 2784**PRODUCTION**

1st 24 hrs. Nat. _____

1st 24 hrs. after shot _____

Gas _____ Cu. Ft.

✓ Dry Hole _____

Abandoned _____

Date

DEC 1 8 1946

19

S. J. LEWIS

Scout