

KANSAS


FORM 51 5M 6-46 PETROL

Kearny county

Section 9 Township 25 Range 35-W

Well No. #1, Campbell

Company Osborne etal

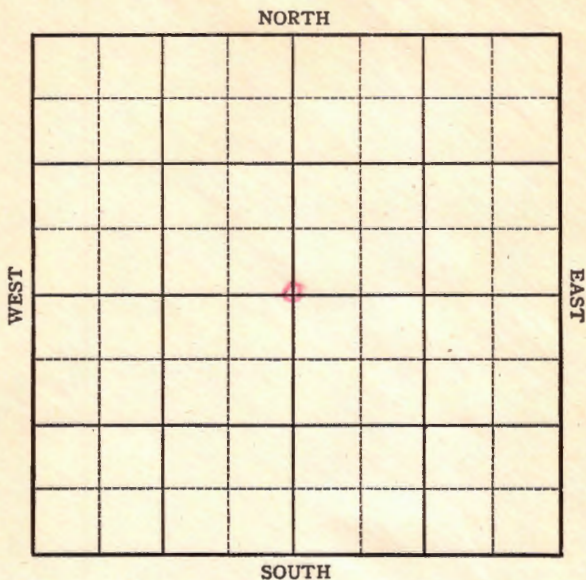

KANSAS

Kearney ✓

Sec. 9 Twp. 25 R. 35W

Well No. #1 Campbell Farm
Osborne etal Company


Hugoton Pool

2640 Ft. from N. Line

Ft. from S. Line

2640 Ft. from E. Line

Ft. from W. Line

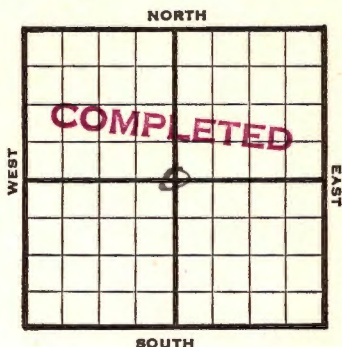

C. Sec.

1946

Elev. 3004'

REPORT

	Location
10/23	
10/29	"
11/6	"
11/12	"
11/20	10" @ 550 WOC
11/27	Drill 2371'
12/3	SD
12/10	7" @ 2686'
	TD 2706'
	RUST

12/17 " "

1947

1/4 7" @ 2686
TD2706, RUST

1/8 " "

1/15 **586 shots 2438**
2634-19000 Acid

1/21 " " "

1/30 Total 43000 Acid

2/5 " "

2/12 " "

COMPLETED

OVER

2/19 Tbtal 43000 Acid

2/26 " "

3/4 TD 2706'

3/11 " "

3/26 7" @ 2686'

Perf.

43000 Acid

3,205,000 Gas.

395# R. Pr.

TD 2706'

COMPLETED

KANSAS

Map No. _____ Sec. 9 Twp. 25 R. 35W

Well No. 1 Campbell

Osborne et al. Company

FIRST REPORT

Contractor

C Sec.


SECTION PLAT

2640 Ft. from N. Line

_____ Ft. from S. Line

2640 Ft. from E. Line

_____ Ft. from W. Line

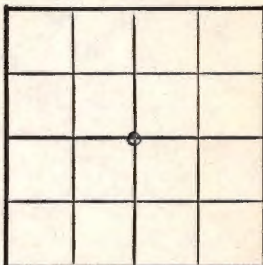

Kearny County

Location X

Rig up _____

Drilling and Remarks:

RECORD

Cased _____ in., _____ ft.

Sand _____

Gas _____

Oil _____

Total Depth _____

PRODUCTION

1st 24 hrs. Nat. _____

1st 24 hrs. after shot _____

Gas _____ Cu. Ft.

Dry Hole _____

Abandoned _____

Date

OCT 23 1946

19

S. J. LEWIS

Sc

Kansas

Map No. _____ Sec. 9 Twp. 25 R. 35WWell No. 1 CampbellOsborne et al. Company


COMPLETE

Contractor

C Sec.

E1-3004

SECTION PLAT

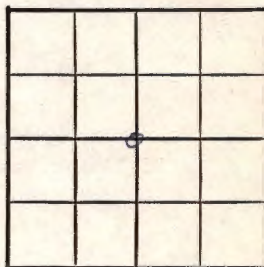2640 Ft. from N. Line

_____ Ft. from S. Line

2640 Ft. from E. Line

_____ Ft. from W. Line

Kearny County

Location _____

Rig up _____

Drilling and Remarks:

9" @ 2686Perf.4300000 cu ft3,200,000 Gas0295 * 12

RECORD

Cased _____ in., _____ ft.

Sand _____

Gas _____

Oil _____

Total Depth 2786

PRODUCTION

1st 24 hrs. Nat. _____

1st 24 hrs. after shot _____

Gas _____ Cu. Ft.

Dry Hole _____

Abandoned _____

Date

MAR 26 1947 19

S. J. LEWIS

Scout