

Kearny county


FORM 51 5M 6-46 PETROLEUM

KANSAS

Section 11 Township 25 Range 35-W

Well No. #2, Tate

Company Osborne etal

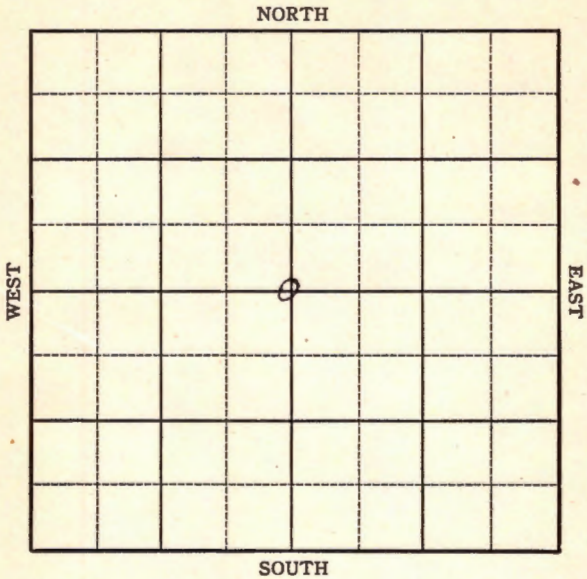

KANSAS

Kearny

Sec. 11 Twp. 25 R. 35W

#2

Well No. #1 Tate Farm

Osborne ETAL Company

Hugoton


2640 Ft. from N. Line

         Ft. from S. Line

2640 Ft. from E. Line

         Ft. from W. Line

NORTH

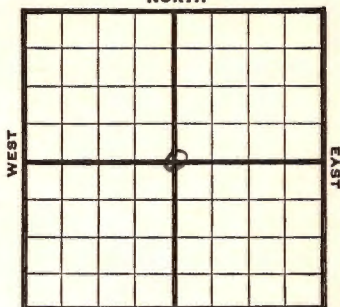

SOUTH

C Sec.

REPORT

1946 **Elev. 2984'**

10/9 Location

10/15 Drlg 200'

10/22 Drlg 400'

10/29 Drlg 920'

11/6 "

11/12 "

11/20 TD 2700

7" @ 2690', RUST

11/27 " "

12/3 " "

12/10 " "

12/17 " "

1947

1/2 7" @ 2690'

TD 2700'

Perf

52000 Acid

29,770,000 Gas

400# RPR

**COMPLETED**

Map No. \_\_\_\_\_ Sec. 11 Twp. 25 R. 35WWell No. 1 TateOsborne Etal. CompanyFIRST REPORT Contractor

C. Sec.


## SECTION PLAT

2640 Ft. from N. Line

\_\_\_\_\_ Ft. from S. Line

2640 Ft. from E. Line

\_\_\_\_\_ Ft. from W. Line

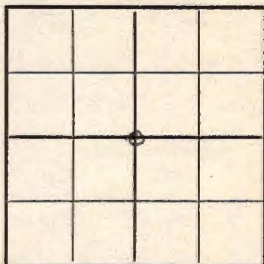Kearny CountyLocation X

Rig up \_\_\_\_\_

Drilling and Remarks:

## RECORD

Cased \_\_\_\_\_ in., \_\_\_\_\_ ft.

Sand \_\_\_\_\_

Gas \_\_\_\_\_

Oil \_\_\_\_\_

Total Depth \_\_\_\_\_

## PRODUCTION

1st 24 hrs. Nat. \_\_\_\_\_

1st 24 hrs. after shot \_\_\_\_\_

Gas \_\_\_\_\_ Cu. Ft.

Dry Hole \_\_\_\_\_

Abandoned \_\_\_\_\_

Date

OCT. 9 1946 19 S. J. LEWIS Scout


Map No. \_\_\_\_\_ Sec. 11 Twp. 25 R. 35WWell No. 2 Tate

Osborne etal. \_\_\_\_\_ Company

CORRECTION \_\_\_\_\_ Contractor

C Sec. \_\_\_\_\_

## SECTION PLAT

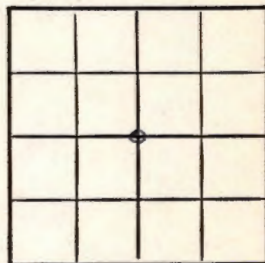2640 Ft. from N. Line

\_\_\_\_\_ Ft. from S. Line

2640 Ft. from E. Line

\_\_\_\_\_ Ft. from W. Line

Kearny County

Location \_\_\_\_\_

Rig up \_\_\_\_\_

Drilling and Remarks: \_\_\_\_\_

Reported

#1 Tate

## RECORD

Cased \_\_\_\_\_ in., \_\_\_\_\_ ft.

Sand \_\_\_\_\_

Gas \_\_\_\_\_

Oil \_\_\_\_\_

Total Depth \_\_\_\_\_

## PRODUCTION

1st 24 hrs. Nat. \_\_\_\_\_

1st 24 hrs. after shot \_\_\_\_\_

Gas \_\_\_\_\_ Cu. Ft.

Dry Hole \_\_\_\_\_

Abandoned \_\_\_\_\_

Date

OCT 16 1946 19

S. J. LEWIS Scout

Map No. \_\_\_\_\_ Sec. 11 Twp. 25 R. 35WWell No. 2 Tate

Osborne et al. \_\_\_\_\_ Company

COMPLETED

Contractor

C Sec.

E/2984

SECTION PLAT

2640 Ft. from N. Line

\_\_\_\_\_ Ft. from S. Line

2640 Ft. from E. Line

\_\_\_\_\_ Ft. from W. Line

Kearny County

Location \_\_\_\_\_

Rig up \_\_\_\_\_

Drilling and Remarks:

7" @ 2690

Prof.

52000 acid

29,970,000 gal

400 # R/R

## RECORD

Cased \_\_\_\_\_ in., \_\_\_\_\_ ft.

Sand \_\_\_\_\_

Gas \_\_\_\_\_

Oil \_\_\_\_\_

Total Depth 2700

## PRODUCTION

1st 24 hrs. Nat. \_\_\_\_\_

1st 24 hrs. after shot \_\_\_\_\_

Gas \_\_\_\_\_ Cu. Ft.

Dry Hole \_\_\_\_\_

Abandoned \_\_\_\_\_

Date

JAN 2 1947 19

S. J. LEWIS Scout