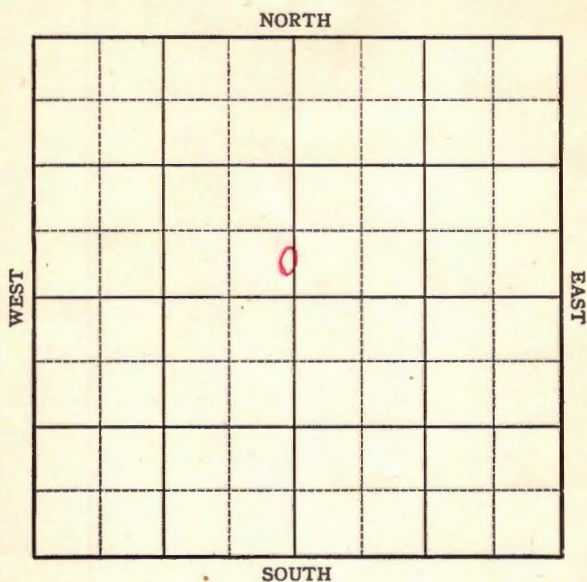


KANSAS

Kearny county

Section 13 Township 25 Range 35-WWell No. #1, DeanCompany Kansas Natural Gas Company

Sec. 13 Twp. 25 R. 35W

Well No. #1 Dean Farm

Kansas Nat. Gas Company


Hugoton

Ft. from N. Line

550 Ft. from S. Line

2640 Ft. from E. Line

Ft. from W. Line

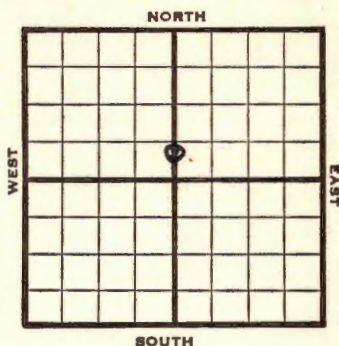

CSL N $\frac{1}{2}$ Sec.

1946 Elev. 2972'

REPORT

	Location
5/29	"
6/5	"
6/12	"
6/18	"
6/26	"
7/3	"
7/9	"
7/16	"
7/23	"
7/30	"
8/6	"
8/13	"
8/20	"
8/27	"
9/5	Location Abandoned

ABANDONED

Pool Name Hugoton
KansasMap No. _____ Sec. 13 Twp. 25 R. 35WWell No. 1 Dean

Kansas Natural Gas Company

ABANDONED

Contractor

C SL N $\frac{1}{2}$ Sec.

E1, 2972

SECTION PLAT

_____ Ft. from N. Line

500 Ft. from S. Line2640 Ft. from E. Line

_____ Ft. from W. Line



Kearny County

Location ✓

Rig up _____

Drilling and Remarks:

RECORD

Cased _____ in., _____ ft.

Sand _____

Gas _____

Oil _____

Total Depth _____

PRODUCTION

1st 24 hrs. Nat. _____

1st 24 hrs. after shot _____

Gas _____ Cu. Ft.

Dry Hole _____

Abandoned _____

Date

SEP 5 1946 19

S. J. LEWIS Scout

KANSASKansas Pool Name HugotonMap No. _____ Sec. 13 Twp. 25 R. 35WWell No. 1 Dean

Kansas Natural Gas

Company _____

FIRST REPORT


Contractor _____

C ~~S~~ L N $\frac{1}{2}$ Sec.**SECTION PLAT**

_____ Ft. from N. Line

500 Ft. from S. Line2640 Ft. from E. Line

_____ Ft. from W. Line

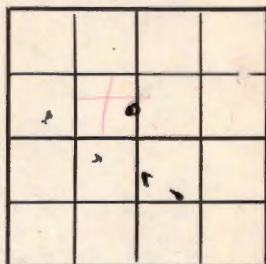Kearny CountyLocation X

Rig up _____

Drilling and Remarks: _____

RECORD

Cased _____ in., _____ ft.

Sand _____

Gas _____

Oil _____

Total Depth _____

PRODUCTION

1st 24 hrs. Nat. _____

1st 24 hrs. after shot _____

Gas _____ Cu. Ft.

Dry Hole _____

Abandoned _____

Date

MAY 29 1946

19

S. J. LEWIS

Scout