

KANSAS


Kearny County

FORM 51 5M 6-46 PETROL

Section 15 Township 25 Range 35W

Well No. #2 Tate

Company Fin-Ker

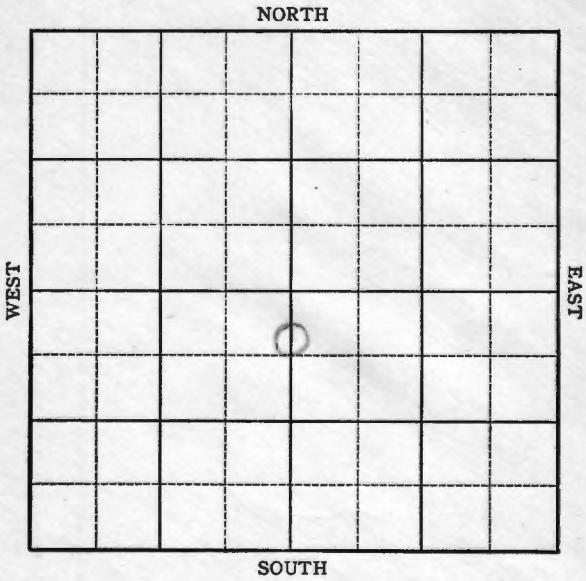

KANSAS

Kearny County

✓

Sec. 15 Twp. 25 R. 35W

Well No. #2 Tate Farm

Fin-Ker Company

Hugoton


650 Ft. from N. Line

Ft. from S. Line

2640 Ft. from E. Line

Ft. from W. Line

C N/2 S/2 Sec.

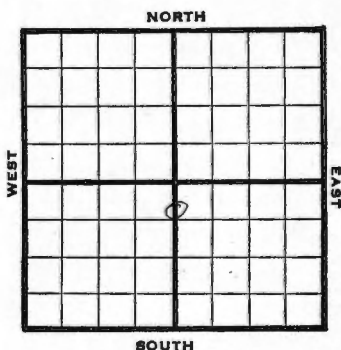

1946

2985

REPORT

7/17 RUR
7/23 Drlg 800'
7/30 10" @ 1476
Drlg 2245'
8/6 TD 2750
7" @ 2738 RUST
8/13 " "
8/20 " "
8/27 TD 2750'
9/5 "
9/10 "
9/18 "
9/24 "
10/1 "
10/8 "
10/15 "
10/22 "
10/29 "
11/6 "
11/12 "
11/20 "
11/27 43000 acid

OVER

1946

12/4

7" @ 2738'

TD 2740'

Perf

43,000 Acid

3,735,000 Gas

405# R PR

COMPLETED

NSAS Kansas Pool Name Hugoton
 Map No. N/M Sec. 15 Twp. 25 R. 35W
 Well No. 2 Tate

Fin-Ker


Company

FIRST REPORT

Contractor

CN $\frac{1}{2}$ S $\frac{1}{2}$ Sec.

SECTION PLAT

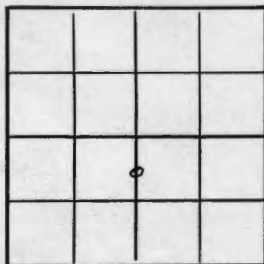650 Ft. from N. Line Ft. from S. Line2640 Ft. from E. Line Ft. from W. LineKearny County

Location

Rig up

Drilling and Remarks:

R U R

RECORD

Cased in., ft.Sand Gas Oil Total Depth

PRODUCTION

1st 24 hrs. Nat. 1st 24 hrs. after shot Gas Cu. Ft.Dry Hole Abandoned

Date

JUL 17 1946 19 S. J. LEWIS Scout


Map No. _____ Sec. 15 Twp. 25 R. 35WWell No. 2 Tate

Fin-Ker

Company _____

COMPLETED

Contractor

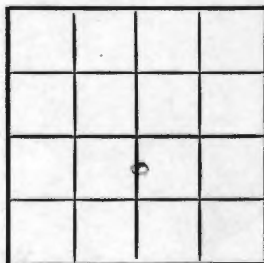C $N\frac{1}{2}$ S $\frac{1}{2}$ Sec.E12985**SECTION PLAT**650 Ft. from N. Line

_____ Ft. from S. Line

2640 Ft. from E. Line

_____ Ft. from W. Line

Kearny County

Location _____

Rig up _____

Drilling and Remarks:

7" C 2738

Prof.
48,000 acril
8, 25,000 Gas.

400 # R/R**RECORD**

Cased _____ in., _____ ft.

Sand _____

Gas _____

Oil _____

Total Depth 2740**PRODUCTION**

1st 24 hrs. Nat. _____

1st 24 hrs. after shot _____

Gas _____ Cu. Ft.

Dry Hole _____

Abandoned _____

Date

DEC 4 1946 19S. J. LEWIS Scout