


Section 18 Township 25 Range 35W

Well No. 1 Campbell


Company Helmerick & Payne

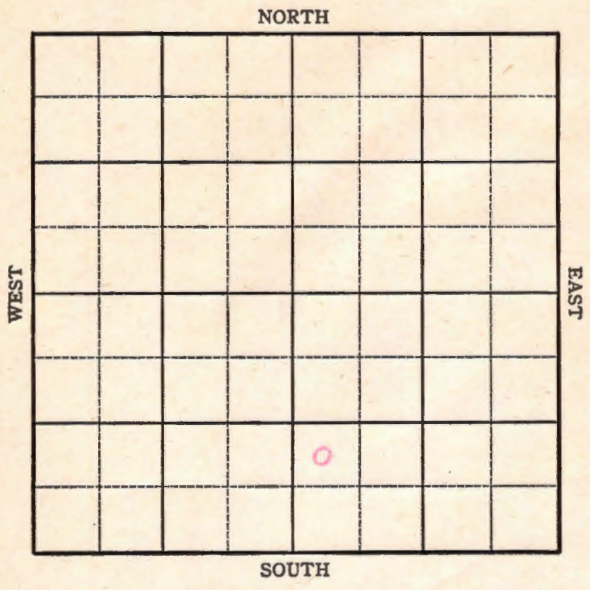

Sec. 18 Twp. 25 R. 35-W

Well No. #1 Campbell Farm
Helmerick & Payne Company

_____ Ft. from N. Line
990 Ft. from S. Line
_____ Ft. from E. Line
330 Ft. from W. Line

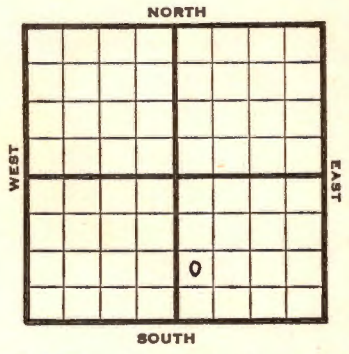

NW SW SE

1945 **Elev. 3014** REPORT

9/5	Drlg. 808'				
9/12	10" @ 795 1700 fsg.				
9/19	Drlg. 2186				
9/26	TD 2766				
	7" @ 2558' RUST				
10/3	"	"	"	"	"
10/10	"	"	"	"	"
10/17	"	"	"	"	"
10/24	Perf. 142 shots 2430-2626				
10/31	"	"	"	"	"
11/7	"	"	"	"	"
11/14	"	"	"	"	"
11/21	"	"	"	"	"
11/28	"	"	"	"	"
12/5	7500 acid.				
12/12	5000 acid.				
12/20	"	"	"	"	"
12/29	"	"	"	"	"
1946					
1/10	Total of 27,000 acud. 13,958,000 cu. ft. gas.				
1/17	"	"	"	"	"
1/24	"	"	"	"	"

OVER

1946

1/30 7" @ 2758
Perf. 27000 acid.
TD 2766'
13,605,000 Gas.

COMPLETED

