


Section 22 Township 25 Range 35-W

Well No. #1 Tate

Company Fin-Ker Oil & Gas

NORTH Houghton Pool

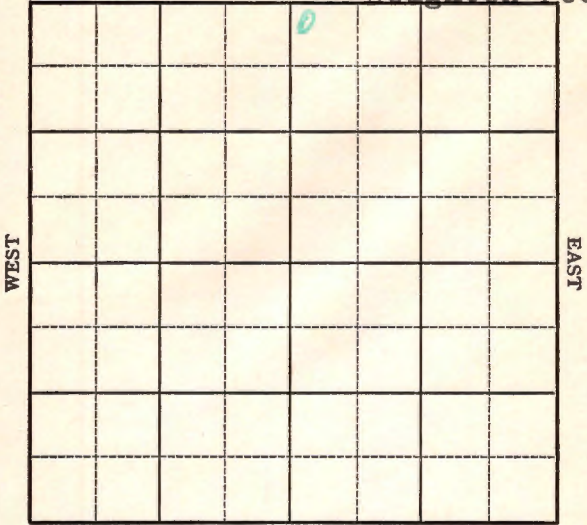

SOUTH

**KANSAS**

Kearny

Sec. 22 Twp. 25 R. 35-W

Well No. #1 Tate Farm \_\_\_\_\_

Fin-Ker Oil & Gas Company \_\_\_\_\_


(Houghton)

53 Ft. from N. Line

\_\_\_\_\_ Ft. from S. Line

\_\_\_\_\_ Ft. from E. Line

42 Ft. from W. Line

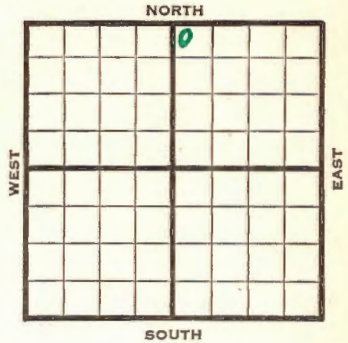

**Elev. 2991**

1942	REPORT
3/25	Rotary.
4/2	Drlg. 400'
4/8	10" - 539' Drlg. 1600'
4/15	7" - 2455' RUST.
4/22	Drlg. 2507' SS/Gas.
4/29	T.D. 2680' 238' of 5" perforated liner to 2680' 1 M gas.
5/6	21,750 acid. 7,210,000 cu. ft. gas.
5/13	" " " "
5/20	" " " "
5/27	" " " "
6/3	<b>Herrington 2455'</b> 7" - 2455' T.D. 2680' 238' of 5" perf. liner 2680' 21,500 acid. 7,210,000 cu. ft. gas.
	<b>COMPLETED</b>

Kearny

**KANSAS**

Map No. MM Sec. 22 Twp. 25 R. 35W

Well No. 1 Tate

Fin-Ker Oil & Gas Company

**FIRST REPORT** Contractor

NW NE

**SECTION PLAT**

		o	

53 Ft. from N. Line

\_\_\_\_\_ Ft. from S. Line

\_\_\_\_\_ Ft. from E. Line

42 Ft. from W. Line

**HOUGHTON POOL**

Location \_\_\_\_\_

Rig up \_\_\_\_\_

Drilling and Remarks:

Rotary

**RECORD**

Cased \_\_\_\_\_ in., \_\_\_\_\_ ft.

Sand \_\_\_\_\_

Gas \_\_\_\_\_

Oil \_\_\_\_\_

Total Depth \_\_\_\_\_

**PRODUCTION**

1st 24 hrs. Nat. \_\_\_\_\_

1st 24 hrs. after shot \_\_\_\_\_

Gas \_\_\_\_\_ Cu. Ft.

Dry Hole \_\_\_\_\_

Abandoned \_\_\_\_\_

Date

MAR 25 1942 19

S. J. LEWIS

Scout

Kearny

KANSAS

Map No. MM Sec. 22 Twp. 25 R. 35W

Well No. 1 Tate

Fin-Ker Oil & Gas Company

**COMPLETED** Contractor

NW NE

SECTION PLAT

		0	

53 Ft. from N. Line

\_\_\_\_\_ Ft. from S. Line

\_\_\_\_\_ Ft. from E. Line

42 Ft. from W. Line

HOUGHTON POOL

Location \_\_\_\_\_

Rig up \_\_\_\_\_

Drilling and Remarks:

*Herrington 2455*  
*3" @ 2455*  
*238' x 5" Pay lines*  
*2680*  
*21500 acid*  
*7,210,000 @ 1/2*  
*Gas*

RECORD

Cased \_\_\_\_\_ in., \_\_\_\_\_ ft.

Sand \_\_\_\_\_

Gas \_\_\_\_\_

Oil \_\_\_\_\_

Total Depth 2680

PRODUCTION

1st 24 hrs. Nat. \_\_\_\_\_

1st 24 hrs. after shot \_\_\_\_\_

Gas \_\_\_\_\_ Cu. Ft.

Dry Hole \_\_\_\_\_

Abandoned \_\_\_\_\_

Date

JUN -3 1942 19

S. J. LEWIS Scout