

KANSAS

Kearny

Section 25 Township 25 Range 35WWell No. 1 Tate-FinusaneCompany MagnoliaHugoton
NORTH

WEST

				0			

EAST

SOUTH

KANSAS

Kearny



Sec. 25 Twp. 25 R. 35N

Well No. #1 Tate - Finusane Farm

Magnolia Company


Hugoton Pool (Barnett Drlg. CO. 084TH)

330' Ft. from N. Line

Ft. from S. Line

Ft. from E. Line

330' Ft. from W. Line

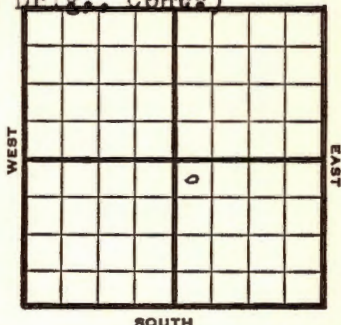

NW SE

1949

Elev. 2993' REPORT

5/11 10" @ 850'

5/18 TD 2750'
6" @ 2749'

5/25 "

6/1 480 shots 2524-2701 - 28,000 acid

6/7 "

6/15 "

6/22 6" @ 2749'

Perf.

35,000 acid

Gas 37,950,000

R. Pr. 384#

TD 2750

COMPLETED

Kaliwat

Map No. _____ Sec. 25 Twp. 25 R. 35WWell No. 1 Tate - Finusane_____ Magnolia _____ Company_____ Barnett Drlg. _____ Contractor

NW SE

FIRST REPORT
SECTION PLAT330 _____ Ft. from N. Line

_____ Ft. from S. Line

_____ Ft. from E. Line

330 _____ Ft. from W. Line

		•	

Kearny County

Location _____

Rig up _____

Drilling and Remarks:

10" @ 850

RECORD

Cased _____ in., _____ ft.

Sand _____

Gas _____

Oil _____

Total Depth _____

PRODUCTION

1st 24 hrs. Nat. _____

1st 24 hrs. after shot _____

Gas _____ Cu. Ft.

Dry Hole _____

Abandoned _____

Date

MAY 11 1949 19S. J. LEWIS Scout

Kansas


Map No. ✓ Sec. 25 Twp. 25 R. 35WWell No. 1 Tate - FinusaneMagnolia

Company

COMPLETE

Contractor

NW SE

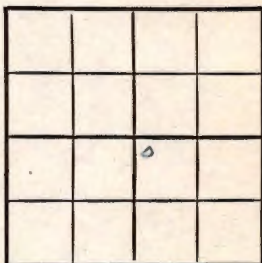E1292
SECTION PLAT330 Ft. from N. Line Ft. from S. Line Ft. from E. Line330 Ft. from W. Line

Kearny County

RECORD

Location

Cased in., ft.

Rig up

Sand

Drilling and Remarks:

Gas Oil Total Depth 2250

PRODUCTION

1st 24 hrs. Nat. 1st 24 hrs. after shot Gas Cu. Ft.Dry Hole Abandoned

Date

JUN 22 1949

19

S. J. LEWIS

Scout

6 "C2749

Prof.

good sand

37,950,000 Gas

384 * R A