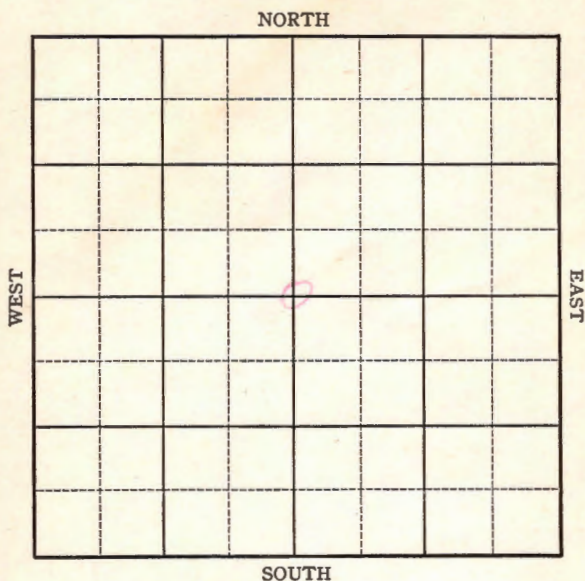
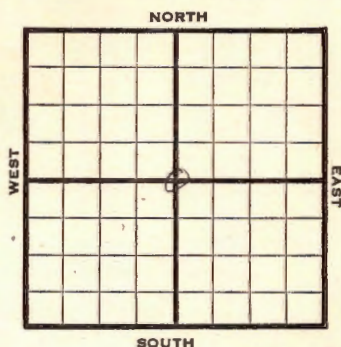


KANSAS

Kearney

Section 30 Township 25 Range 35WWell No. #10 ~~#8~~ CampbellCompany Fin-Kerr Oil and Gas

KANSAS**Kearney County**Sec. 30 Twp. 25 R. 35WWell No. #10 ~~#9~~ **Campbell** Farm**Fin-Kerr Oil & Gas** Company**Hugoton**2640 Ft. from N. Line Ft. from S. Line2640 Ft. from E. Line Ft. from W. Line**EDF 3022**
GR 3020

1944

REPORT

7/19

Loc.

7/26

"

8/2

"

8/9

~~Surface Hole~~ *Rotary*

8/16

10" @ 560 Drlg. 1136

8/23

" " " " "

8/30

" " " " "

9/8

TD 2748 9" @ 2748

36 shots 2448-60

45 " 2515-30

36 " 2562-74

66 " 2620-42

84 " 2648-76

18 " 2702-08

to acidize

9/13

" " " " "

9/21

20000 acid

9/28

" "

10/4

" "

10/11

" "

10/18

2500 acid 26,570,000 gas

10/25

7" @ 2748

Perf. 2448-2708

22500 acid

31,588,000 GAS

TD 2748

COMPLETED

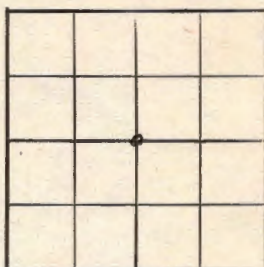
KANSASPool Name HugotonMap No. W M Sec. 30 Twp. 25 R. 35WWell No. 9 CampbellFin-Kerr Oil & Gas

Company

FIRST REPORT

Contractor

C Sec.

SECTION PLAT2640 Ft. from N. Line Ft. from S. Line2640 Ft. from E. Line Ft. from W. LineKearney CountyLocation XRig up

Drilling and Remarks:

RECORDCased in., ft.Sand Gas Oil Total Depth **PRODUCTION**1st 24 hrs. Nat. 1st 24 hrs. after shot Gas Cu. Ft.Dry Hole Abandoned

Date

JUL 19 194419S. J. LEWIS

Scout

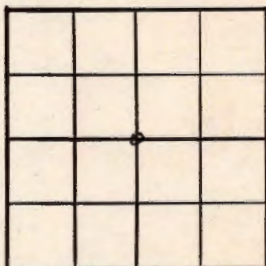
Pool Name Hugoton**KANSAS**Map No. mm Sec. 30 Twp. 25 R. 35WWell No. 10 CampbellFin-Ker Oil & Gas Company

CORRECTION

Contractor

C Sec.

SECTION PLAT

2640 Ft. from N. Line Ft. from S. Line2640 Ft. from E. Line Ft. from W. LineKearney CountyLocation Rig up

Drilling and Remarks:

Reported as
#9 Campbell

RECORD

Cased in., ft.Sand Gas Oil Total Depth

PRODUCTION

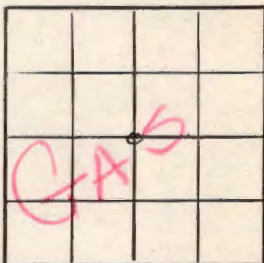
1st 24 hrs. Nat. 1st 24 hrs. after shot Gas Cu. Ft.Dry Hole Abandoned

Date

AUG 9 1944 19 S. J. LEWIS Scout

KANSASPool Name Hugoton PoolMap No. N/M Sec. 30 Twp. 25 R. 35WWell No. 10 CampbellFin-terr Oil & Gas Company**COMPLETED**

Contractor

C. SEC.**SECTION PLAT**2640 Ft. from N. Line Ft. from S. Line2640 Ft. from E. Line Ft. from W. LineKearny CountyLocation Rig up

Drilling and Remarks:

7" @ 2748.Prof. 2448-270822500 cu. ft.31,588,000 gal.**RECORD**Cased in. ft.Sand Gas Oil Total Depth 2748**PRODUCTION**1st 24 hrs. Nat. 1st 24 hrs. after shot Gas Cu. Ft.Dry Hole Abandoned

Date

OCT 25 194419S. J. LEWIS Scout