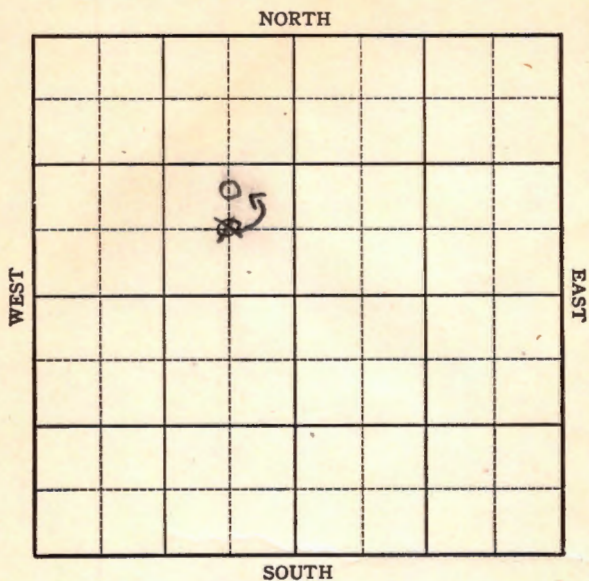


KANSAS

Kearny county

Section 31 Township 25 Range 35-WWell No. #15, CampbellCompany Fin-Ker

KANSAS

Kearny

Sec. 31 Twp. 25 R. 35W

Well No. #15 Campbell Farm
Fin-Ker Company

Hugoton

Ft. from N. Line


940

Ft. from S. Line

590

Ft. from E. Line

Ft. from W. Line

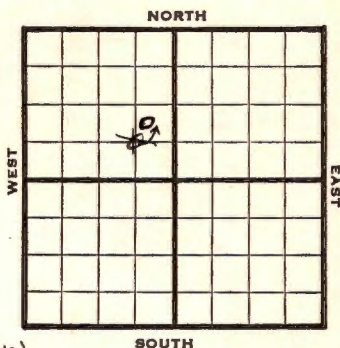

SE NW C n d S E NW

1946

REPORT

10/9	Location
10/15	"
10/22	10" @ 1575'
	Drlg 1750'
10/29	TD 2750
	7" @ 2739, RUST
11/6	" "
11/12	" "
11/20	700 shots 2450-2660'
11/27	" "
12/3	" "
12/10	" "
12/17	" "
1947	
1/4	700 shots 2450-26, CO
1/8	" "
1/15	" "
1/21	" "
1/30	" "
2/5	" "
2/12	" "

OVER

2/19 TD 2750'

2/26 " "

3/12 7" @ 2739'

Perf

50000 Acid

2,048,000 Gas

383# R Pr

TD 2750'

COMPLETED

KANSAS
 Kansas Hugoton

Map No. _____ Sec. 31 Twp. 25 R. 35WWell No. 15 Campbell

Fin-Ker

Company

FIRST REPORT

Contractor


C SE NW

SECTION PLAT

_____ Ft. from N. Line

600 Ft. from S. Line600 Ft. from E. Line

_____ Ft. from W. Line

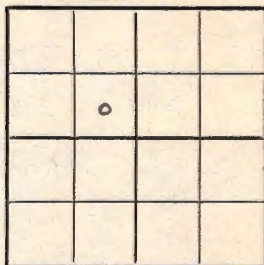Kearny CountyLocation X

Rig up _____

Drilling and Remarks:

RECORD

Cased _____ in., _____ ft.

Sand _____

Gas _____

Oil _____

Total Depth _____

PRODUCTION

1st 24 hrs. Nat. _____

1st 24 hrs. after shot _____

Gas _____ Cu. Ft.

Dry Hole _____

Abandoned _____

Date

OCT 9 1946 19 S. J. LEWIS Scout

KANSASMap No. _____ Sec. 31 Twp. 25 R. 35WWell No. 15 Campbell

Fin-Ker

Company

CORRECTION

Contractor

C N L SE NW

SECTION PLAT

	o		

_____ Ft. from N. Line

940

_____ Ft. from S. Line

590

_____ Ft. from E. Line

_____ Ft. from W. Line

Kearny County

Location _____

Rig up _____

Drilling and Remarks:

Reported

600 S.L.

600 E.L.

RECORD

Cased _____ in., _____ ft.

Sand _____

Gas _____

Oil _____

Total Depth _____

PRODUCTION

1st 24 hrs. Nat. _____

1st 24 hrs. after shot _____

Gas _____ Cu. Ft.

Dry Hole _____

Abandoned _____

Date

OCT 23 1946

19

S. J. LEWIS

Scout

Map No. _____ Sec. 31 Twp. 25 R. 35WWell No. 15 Campbell

Fin-Ker

Company


COMPLETE

Contractor

C N L SE NW

E 13023

SECTION PLAT

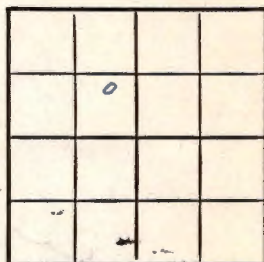

_____ Ft. from N. Line

940 Ft. from S. Line590 Ft. from E. Line

_____ Ft. from W. Line

Kearny County

Location _____

Rig up _____

Drilling and Remarks:

7" @ 1239

Perf.

50000 acvil

2,048,800 Gas

383 R R

RECORD

Cased _____ in., _____ ft.

Sand _____

Gas _____

Oil _____

Total Depth 2700

PRODUCTION

1st 24 hrs. Nat. _____

1st 24 hrs. after shot _____

Gas _____ Cu. Ft.

Dry Hole _____

Abandoned _____

Date

MAR 12 1947 19

S. J. LEWIS Scout