


Section 33 Township 25 Range 35W

Well No. 1 Ward-Tate

Company Magnolia

Hugoton
NORTH

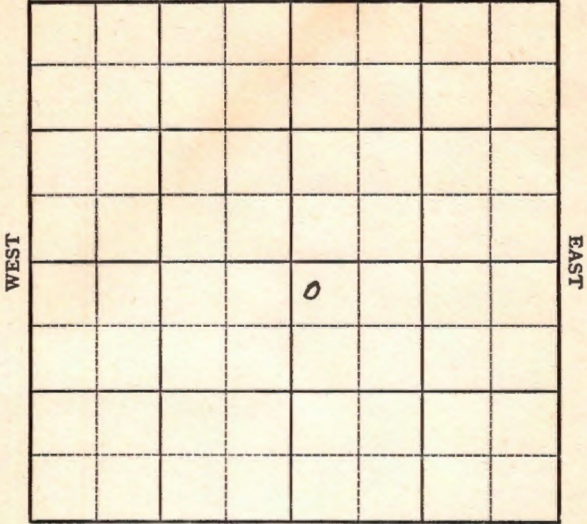

SOUTH

KANSAS

Kearny



Sec. 33 Twp. 25 R. 35W


Well No. #1 Ward - Tate Farm

Magnolia Company

Hugoton (Barnett Drlg., Cont.)

NORTH

Pool 330' Ft. from N. Line

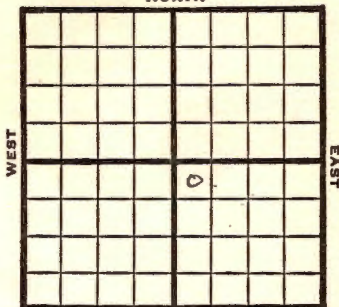

_____ Ft. from S. Line

_____ Ft. from E. Line

330' Ft. from W. Line

NW SE

SOUTH

1949

Elev 3003' REPORT

6/1 10" @ 816'

6/7 TD 2771

6" @ 2770'

6/15 "

6/21 406 shots 2580-2619 - 28,000 acid

6/28 192 shots 2495-2562 - 21,000 acid

7/6 "

7/13 TD 2771'

6" @ 2770'

Perf 42000 acid

28,500,000 Gas

370# R Pr.

Comp

COMPLETED

Map No. _____ Sec. 33 Twp. 25 R. 35W

Well No. 1 Ward - Tate

Magnolia Company

Barnett Drlg. Contractor

NW SE

FIRST REPORT
SECTION PLAT

330 Ft. from N. Line

_____ Ft. from S. Line

_____ Ft. from E. Line

330 Ft. from W. Line

		o	

Kearny County

Location _____

Rig up _____

Drilling and Remarks:

10" @ 816

RECORD

Cased _____ in., _____ ft.

Sand _____

Gas _____

Oil _____

Total Depth _____

PRODUCTION

1st 24 hrs. Nat. _____

1st 24 hrs. after shot _____

Gas _____ Cu. Ft.

Dry Hole _____

Abandoned _____

Date

JUN 1 1949 19

S. J. LEWIS

Scout

Kansas

Map No. _____ Sec. 33 Twp. 25 R. 35W

Well No. 1 Ward - Tate

Magnolia Company

COMPLETE Contractor

NW SE

E. 3003
SECTION PLAT

330 Ft. from N. Line

_____ Ft. from S. Line

_____ Ft. from E. Line

330 Ft. from W. Line

		0	

Kearny County

RECORD

Location _____

Cased _____ in., _____ ft.

Rig up _____

Sand _____

Drilling and Remarks:

Gas _____

Oil _____

Total Depth 2221

PRODUCTION

1st 24 hrs. Nat. _____

1st 24 hrs. after shot _____

Gas _____ Cu. Ft.

Dry Hole _____

Abandoned _____

6" 02770
Prof.
42000 acid
25,000,000 gal
370" RR

Date

JUL 13 1949 19

S. J. LEWIS Scout