

KANSAS KearnySection 34 Township 25 Range 35WWell No. 1 O. Akers UnitCompany Magnolia**Hugoton**

NORTH

				0			

WEST

EAST

SOUTH

KANSAS

Kearny

Sec. 34 Twp. 25 R. 35W ✓

Well No. #1 O. Akers Unit Farm

Magnolia Company

Hugoton (Barnett Drlg., Cont.) NORTH
330'

Ft. from N. Line


Ft. from S. Line

Ft. from E. Line

330'

Ft. from W. Line

NW SE

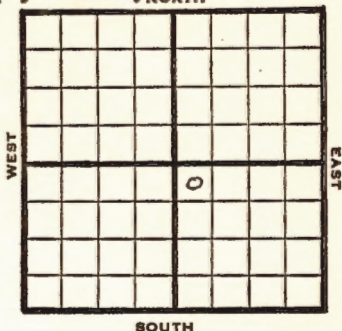

1949

Elev 3000'

REPORT

6/1 10" @ 833'
Drlg. 2080'
6/7 TD 2790'
6" @ 2789'
6/15 456 shots 2555-2722 - 28,000 acid
6/21 144 shots 2500- 2546 - 14,000 acid
6/29 TD 2790'
6" @ 2789'
Perf 42000 Acid
32,300,000 Gas
388# R Pr.
Comp

COMPLETED

Map No. _____ Sec. 34 Twp. 25 R. 35W

Well No. 1 O. Akers Unit

Magnolia Company

Barnett Drlg. Contractor

NW SE

FIRST REPORT
SECTION PLAT

		0	

330 Ft. from N. Line

_____ Ft. from S. Line

_____ Ft. from E. Line

330 Ft. from W. Line

Kearny County

Location _____

Rig up _____

Drilling and Remarks:

10" @ 833

drlg. 2080

RECORD

Cased _____ in., _____ ft.

Sand _____

Gas _____

Oil _____

Total Depth _____

PRODUCTION

1st 24 hrs. Nat. _____

1st 24 hrs. after shot _____

Gas _____ Cu. Ft.

Dry Hole _____

Abandoned _____

Date

JUN 1 1949 19

S. J. LEWIS

Scout

Map No. ✓ Sec. 34 Twp. 25 R. 35W

Well No. 1 O. Akers Unit

Magnolia Company

COMPLETE

Contractor

NW SE

E1,9000
SECTION PLAT

330 Ft. from N. Line

 Ft. from S. Line

 Ft. from E. Line

330 Ft. from W. Line

		4	

Kearny County

Location

Rig up

Drilling and Remarks:

6" 0278F

*Prof.
Kearny*

32,900,000 gal

388-RP

RECORD

Cased in., ft.

Sand

Gas

Oil

Total Depth 2790

PRODUCTION

1st 24 hrs. Nat.

1st 24 hrs. after shot

Gas Cu. Ft.

Dry Hole

Abandoned

Date

JUN 28 1949 19

S. J. LEWIS

Scout