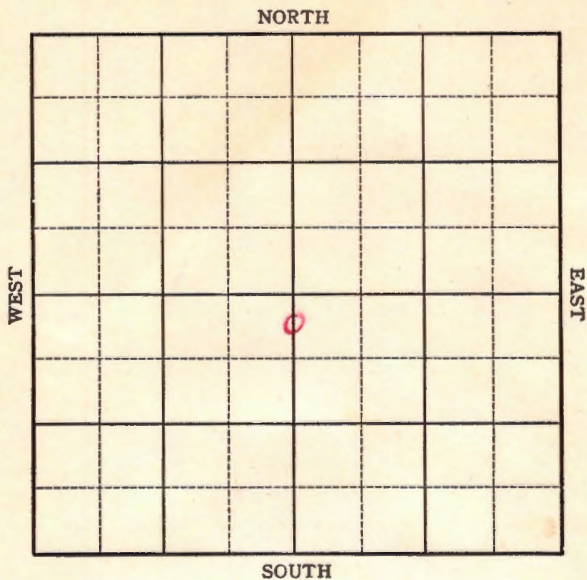


KANSAS

Kearny county

Section 2 Township 25 Range 35-WWell No. #2, KrieteCompany Fin-Ker

KANSAS

Kearny County

Sec. 2 Twp. 25 R. 35W

Well No. #2 Kriete Farm _____
Fin-Ker _____ Company _____

Hugoton

500 Ft. from N. Line


_____ Ft. from S. Line

2640

_____ Ft. from E. Line

_____ Ft. from W. Line

CN/2 S/2 Sec.

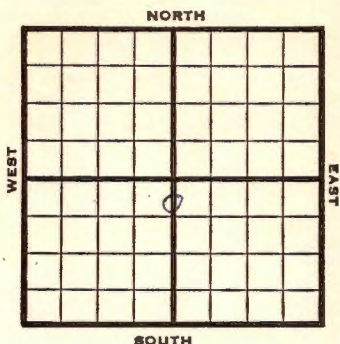

1946

REPORT

~~Flav~~ 3989'

5/15 RUR

5/21 Drlg 1458'

5/29 10" @ 1551

Drlg. 2400'

6/5 TD 2746

7" @ 2745 RUST

6/12 264 shots 2452 to 2660

6/18 11500 acid

6/26 " "

7/3 Total of 32000 acid

7/9 " "

7/16 " "

7/23 " "

7/30 " "

8/6 " "

8/13 " "

8/20 " "

8/27 " "

9/5 " "

9/10 " "

9/18 " "

RECEIVED

1946

9/25 7" @ 2745'
Perf
32,000 Acid
2,132,000 Gas
TD 2746'
RPR 408#

COMPLETED

Kansas Pool Name Hugoton Pool**KANSAS**Map No. _____ Sec. 2 Twp. 25 R. 35WWell No. 2 KrieteFin-Ker

Company _____

COMPLETED


Contractor _____

C $N\frac{1}{2}$ S $\frac{1}{2}$ Sec.E/2889
SECTION PLAT500 Ft. from N. Line

_____ Ft. from S. Line

2640 Ft. from E. Line

_____ Ft. from W. Line

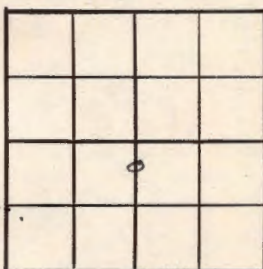Kearney County

Location _____

Rig up _____

Drilling and Remarks:

7" C 2745Prof.32000 acid2,132,000 gas408th R²**RECORD**

Cased _____ in., _____ ft.

Sand _____

Gas _____

Oil _____

Total Depth 2746**PRODUCTION**

1st 24 hrs. Nat. _____

1st 24 hrs. after shot _____

Gas _____ Cu. Ft.

Dry Hole _____

Abandoned _____

Date

SEP 25 1946 19S. J. LEWIS


Scout

KANSASKansas Pool Name HugotonMap No. 1 Sec. 2 Twp. 25 R. 35WWell No. 2 KrieteFin-Ker

Company

FIRST REPORT

Contractor

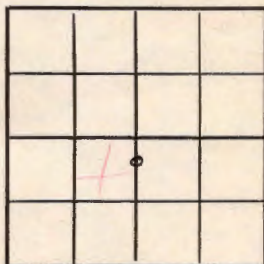CN $\frac{1}{2}$ S $\frac{1}{2}$ Sec**SECTION PLAT**500 Ft. from N. Line Ft. from S. Line2640 Ft. from E. Line Ft. from W. LineKearny CountyLocation Rig up

Drilling and Remarks:

*R. H. H.***RECORD**Cased in., ft.Sand Gas Oil Total Depth **PRODUCTION**1st 24 hrs. Nat. 1st 24 hrs. after shot Gas Cu. Ft.Dry Hole Abandoned

Date

MAY 15 194619S. J. LEWIS

Scout