


Section 6 Township 25 Range 36-W

Well No. #1 White "B"

Company Stanolind

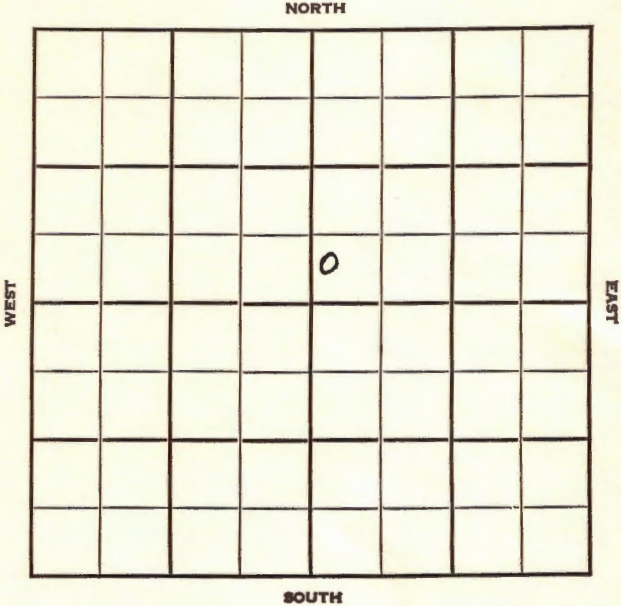

KANSAS

Kearny

Sec. 6 Twp. 25 R. 36W

Well No. #1 White "B" Farm

Stanolind Company

Hugoton Pool

NORTH

450' Ft. from N. Line

150'


Ft. from S. Line

Ft. from E. Line

150'

Ft. from W. Line

SW NE

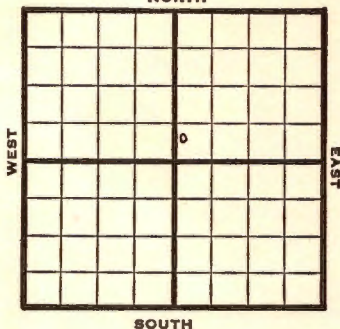

1948

REPORT

5/12 Location

5/19 Drlg. 645'

5/26 10" @ 645'
Drlg. 2300'

6/1 TD 2385'
7" @ 2327'

6/9 211' of 5" Perf liner @ 2385'
72 shots 360-72 16,500 acid

6/16 7" @ 2372'
72 shots 2360-72'
211' of 5" perf liner @ 2514'
16,500 acid.
9,588,000 CFG
410 # R Pr.
Completed

COMPLETED

Map No. _____ Sec. 6 Twp. 25 R. 36W

Well No. 1 White "B"

Stanolind Company

FIRST REPORT

Contractor _____

SW NE

SECTION PLAT

_____ Ft. from N. Line

450 Ft. from S. Line

_____ Ft. from E. Line

150 Ft. from W. Line

		o	

Kearny County

Location X

RECORD

Rig up _____

Drilling and Remarks: _____

Cased _____ in., _____ ft.

Sand _____

Gas _____

Oil _____

Total Depth _____

PRODUCTION

1st 24 hrs. Nat. _____

1st 24 hrs. after shot _____

Gas _____ Cu. Ft.

Dry Hole _____

Abandoned _____

Date

MAY 12 1948 19

S. J. LEWIS

Scout

Map No. _____ Sec. 6 Twp. 25 R. 36W

Well No. 1 White "B"

Stanolind Company

COMPLETE Contractor

SW NE

L. 1,3028
SECTION PLAT

_____ Ft. from N. Line

450 Ft. from S. Line

_____ Ft. from E. Line

150 Ft. from W. Line

Kearny County

RECORD

Location _____

Rig up _____

Drilling and Remarks:

*7" @ 2372
22 slots 2360-72
211' of 5" Pay liner
@ 2514
16500 and
9,588,000 Gas
410² R/P*

Cased _____ in., _____ ft.

Sand _____

Gas _____

Oil _____

Total Depth 2544

PRODUCTION

1st 24 hrs. Nat. _____

1st 24 hrs. after shot _____

Gas _____ Cu. Ft.

Dry Hole _____

Abandoned _____

Date

JUN 16 1948

19

S. J. LEWIS Scout