

KANSAS

Kearny

Section 2 Township 25 Range 36W

Well No. 1 Banntge

Company Champlin Ref.

Hugaton

NORTH

WEST

EAST

			0				

SOUTH

KANSAS

Kearny

Sec. 2 Twp. _____ R. 36N ✓

Well No. #1 Banntge Farm _____
Champlin Ref. _____ Company _____

Hugoton


NORTH

_____ Ft. from N. Line

330' Ft. from S. Line

330' Ft. from E. Line

_____ Ft. from W. Line

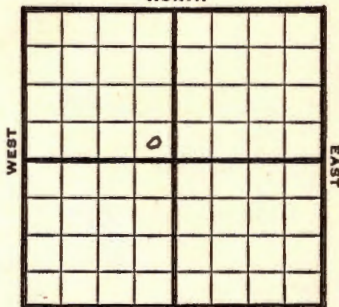

SOUTH

SE NW

1949

Elev 2998'

REPORT

5/4

Location

5/10

13" @ 103'

8" @ 653'

Drig. 2610'

5/18

TD 2579'

5" @ 2549'

5/25

TD 2580' - 1000 acid

180 shots 2434-2527 - 8000 acid

6/1

99 shots 2380-2416 - 20,000 acid

6/7

"

6/15

5" @ 2549'

TD 2580'

Perf 29000 acid

17,869,000 Gas

400# R. Pr.

omp

COMPLETED

Map No. _____ Sec. 2 Twp. 25 R. 36W

Well No. 1 Banntge

Champlin Ref. Company _____

FIRST REPORT Contractor _____

SE NW


SECTION PLAT

_____ Ft. from N. Line

330 Ft. from S. Line

330 Ft. from E. Line

_____ Ft. from W. Line

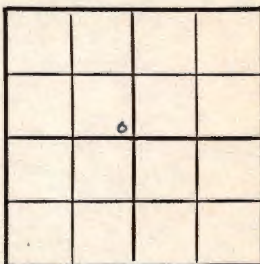

Kearny County

RECORD

Location X

Rig up _____

Drilling and Remarks:

Cased _____ in., _____ ft.

Sand _____

Gas _____

Oil _____

Total Depth _____

PRODUCTION

1st 24 hrs. Nat. _____

1st 24 hrs. after shot _____

Gas _____ Cu. Ft.

Dry Hole _____

Abandoned _____

Date

MAY 4 1949 19 _____

S. J. LEWIS Scout

