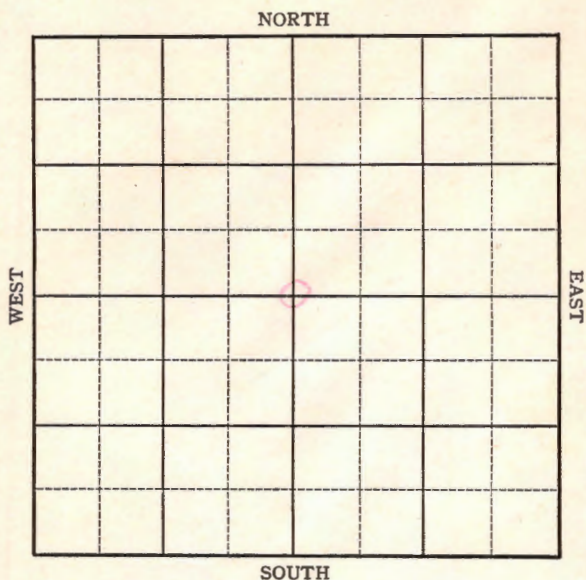


Kearney

Section 13 Township 25 Range 36WWell No. #7 CampbellCompany Fin-Kerr Oil and Gas

KANSAS

Kearney County

Sec. 13 Twp. 25 R. 36W

Well No. #7 Campbell Farm

Fin-Ker Oil & Gas Company

Hugoton


2640 Ft. from N. Line

Ft. from S. Line

2640 Ft. from E. Line

Ft. from W. Line

NORTH

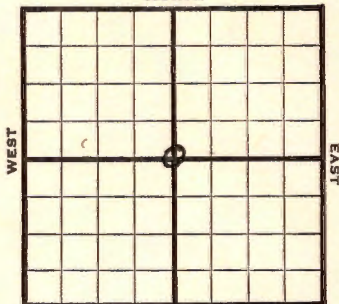

SOUTH

Elev. 3013

1944

REPORT

7/19 Derrick
7/26 10" @ 510 WOC
8/2 Drlg. 1705
8/9 7" @ 2711 RUST
8/16 " " " "
8/23 " " " "
8/30 " " " "
9/8 " " " "
9/13 TD 2720
9/20 7" @ 2711
356 shots 2414-2644
TD 2760
30,012,000 Gas

COMPLETED

KANSASPool Name HugotonMap No. N M Sec. 13 Twp. 25 R. 36 WWell No. 7 CampbellFin-Ker Oil & Gas

Company

FIRST REPORT

Contractor

C Sec.


SECTION PLAT

2640 Ft. from N. Line

Ft. from S. Line

2640 Ft. from E. Line

Ft. from W. Line

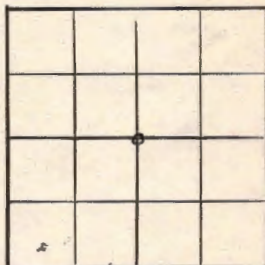Kearney County

Location

Rig up

Drilling and Remarks:

Derrick

RECORD

Cased _____ in., _____ ft.

Sand _____

Gas _____

Oil _____

Total Depth _____

PRODUCTION

1st 24 hrs. Nat. _____

1st 24 hrs. after shot _____

Gas _____ Cu. Ft.

Dry Hole _____

Abandoned _____

Date

JUL 19 1944 19S. J. LEWIS Scout


KANSAS

Pool Name Hugoton PoolMap No. NM Sec. 13 Twp. 25 R. 36WWell No. 7 CampbellFin-Kerr Okl & Gas CompanyCOMPLETED

Contractor

C Sec.

SECTION PLAT

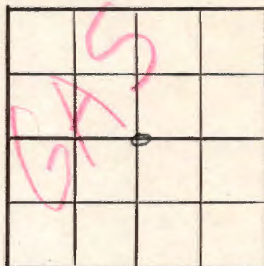2640 Ft. from N. Line

Ft. from S. Line

2640 Ft. from E. Line

Ft. from W. Line

Kearney County

Location

Rig up

Drilling and Remarks:

7" C2711356 a ho to 2414-264530,012,000 Gas

RECORD

Cased _____ in., _____ ft.

Sand _____

Gas _____

Oil _____

Total Depth 2760

PRODUCTION

1st 24 hrs. Nat. _____

1st 24 hrs. after shot _____

Gas _____ Cu. Ft.

Dry Hole _____

Abandoned _____

Date

SEP 20 1944 19S. J. LEWIS Scout