


Section 14 Township 25 Range 36-~~W~~

Well No. #2, Campbell

Company Helmerich and Payne etal

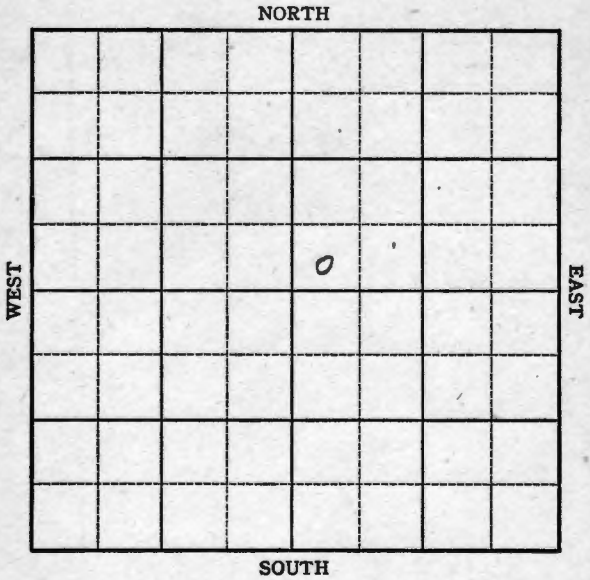

Sec. 14 Twp. 25 R. 36W

Well No. 2 Campbell Farm

Helmerich & Payne et al Company

Hugoton Pool


_____ Ft. from N. Line

330 Ft. from S. Line

_____ Ft. from E. Line

330 Ft. from W. Line

SW NE

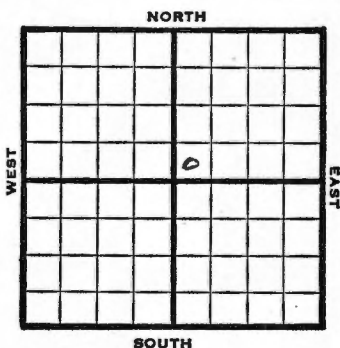

1947

Elev. 3073' REPORT

1/8	Drlg 300'
1/15	Drlg 1500'
1/21	7" @ 2468
1/30	1200 Acid
2/5	TD 2667' 229' of 5" Perf liner @ 2667'
2/12	3000 Acid
2/19	" "
2/26	TD 2667' 7" @ 2468' 229' of 5" Perf liner @ 2667' 30000 Acid 29,326,000 Gas 410# R Pr TD 2667

COMPLETED

Map No. _____ Sec. 14 Twp. 25 R. 36W

Well No. 2 Campbell

Helmerich & Payne etal. Company

FIRST REPORT

Contractor

SW NE

SECTION PLAT

		o	

Ft. from N. Line

330

Ft. from S. Line

Ft. from E. Line

330

Ft. from W. Line

Kearny County

RECORD

Location _____

Cased _____ in., _____ ft.

Rig up _____

Sand _____

Drilling and Remarks:

Gas _____

Oil _____

300'

Total Depth _____

PRODUCTION

1st 24 hrs. Nat. _____

1st 24 hrs. after shot _____

Gas _____ Cu. Ft.

Dry Hole _____

Abandoned _____

Date

JAN 8 1947 19

S. J. LEWIS Scout

Map No. _____ Sec. 14 Twp. 25 R. 36W

Well No. 2 Campbell

Helmerich & Payne et al, Company
COMPLETE

Contractor

SW NE

L¹ 3028
SECTION PLAT

_____ Ft. from N. Line

330 Ft. from S. Line

_____ Ft. from E. Line

330 Ft. from W. Line

		0	

Kearny County

RECORD

Location _____

Cased _____ in., _____ ft.

Rig up _____

Sand _____

Drilling and Remarks:

Gas _____

Oil _____

Total Depth 2667

PRODUCTION

1st 24 hrs. Nat. _____

1st 24 hrs. after shot _____

Gas _____ Cu. Ft.

Dry Hole _____

Abandoned _____

*2667
7' 02 468
229' of 5' Bay line
2667
80000 acid
29,226,500 Gas
#10 * R/B*

Date

FEB 26 1947 19

S. J. LEWIS Scout