

Kearny


FORM 51 IOM 12-46 PETROL

KANSAS

Section 33 Township 25 Range 36W

Well No. 7 Lee

Company Fin-Ker

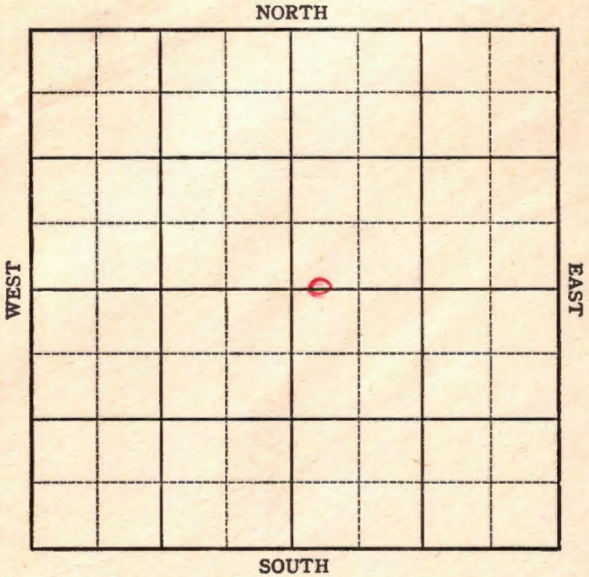

KANSAS

Sec. 33 Twp. 25 R. 36-W

Well No. # 7 Lee Farm

Fin-Ker Company

Hugoton


2640 Ft. from N. Line

~~400~~ Ft. from S. Line

~~220~~ 200 Ft. from E. Line

200 Ft. from W. Line

~~SE NW~~ CWH E 1/2 Sec.

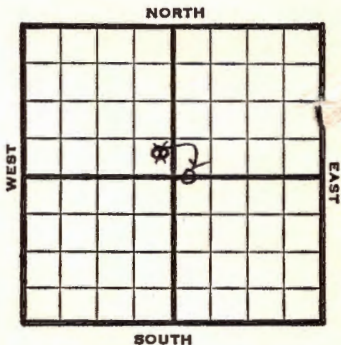

1947

Elev. 3044' REPORT

6/11 Location

6/17 16" @ 115'
Drlg. 1400'

6/24 10" @ 1588'
Drlg. 2620'

7/1 TD 2648'
7" @ 2641'
RUST.

7/8 " "

7/16 " "

7/22 " "

7/29 " "

8/6 " "

8/13 " "

8/20 " "

8/27 " "

9/3 " "

9/10 " "

OVER

1947

9/17

7" @ 2641'

Perf

45,000 Acid

4,034,000 Gas

401# Rock Pressure

Total Depth 2648'

COMPLETED

Map No. _____ Sec. 33 Twp. 25 R. 36W

Well No. 7 Lee

Fin-Ker Company

FIRST REPORT Contractor

SE NW

SECTION PLAT

_____ Ft. from N. Line

400 Ft. from S. Line

220 Ft. from E. Line

_____ Ft. from W. Line

Kearny County

Location _____ X

Rig up _____

Drilling and Remarks:



RECORD

Cased _____ in., _____ ft.

Sand _____

Gas _____

Oil _____

Total Depth _____

PRODUCTION

1st 24 hrs. Nat. _____

1st 24 hrs. after shot _____

Gas _____ Cu. Ft.

Dry Hole _____

Abandoned _____

Date

JUN 1 1947 19

S. J. LEWIS Scout

Map No. 0 Sec. 33 Twp. 25 R. 36W

Well No. 7 Lee

Fin-Ker Company

COMPLETE

Contractor

C W L E $\frac{1}{2}$ Sec.

E13044
SECTION PLAT

		0	

2640 Ft. from N. Line

_____ Ft. from S. Line

_____ Ft. from E. Line

200 Ft. from W. Line

Kearny County

Location _____

Rig up _____

Drilling and Remarks:

7" @ 2641
Prof
45000 acid
4,084,000 Gas
*401 * R/P*

RECORD

Cased _____ in., _____ ft.

Sand _____

Gas _____

Oil _____

Total Depth 2648

PRODUCTION

1st 24 hrs. Nat. _____

1st 24 hrs. after shot _____

Gas _____ Cu. Ft.

Dry Hole _____

Abandoned _____

Date

SEP 17 1947 19

S. J. LEWIS Scout

