

KANSAS


FORM 51 5M 11-44 PETROL

Kearny County

Section 36 Township 25 Range 36N

Well No. #3 Kansas Masonic Home

Company Fin-Ker

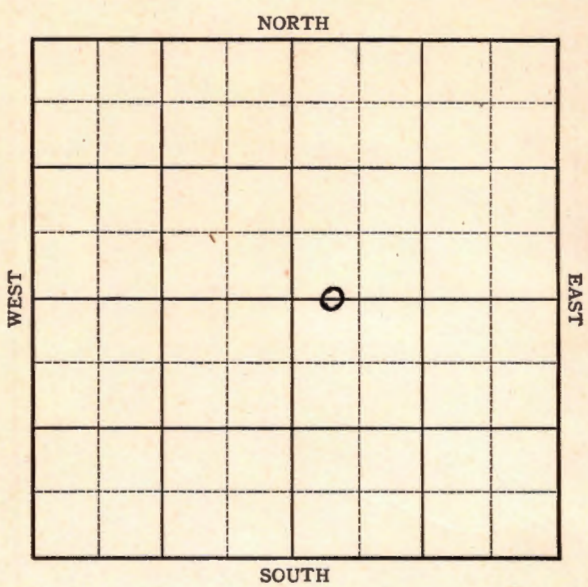

Sec. 36 Twp. 25 R. 36W

Well No. #3, Kansas Masonic Home Farm

Fin-Ker Company


Hugoton

2640 Ft. from N. Line

_____ Ft. from S. Line

_____ Ft. from E. Line

400 Ft. from W. Line

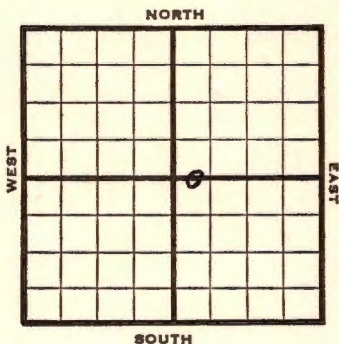

C W 1 E 1/2 Sec.

1946

3039

REPORT

6/12 10" @ 792'
 WOC

6/18 Drlg 2390'

6/26 TD 2754'
 7" @ 2743 RUST

7/3 " "

7/9 Drlg 2560'

7/16 236 shots 2438 to 2642
 1000 acid

7/23 " " "

7/30 12000 acid

8/6 8000 acid 7 M Gas

8/13 " " "

8/20 " " "

8/27 " " "

9/5 " " "

9/10 " " "

9/18 " " "

9/24 " " "

10/1 " " "

10/8 " " "

10/16 7" @ 2743'
 TD 2754'
 Perf

OVER

1946

INFORMATION CARRIED FORWARD

34,000 Acid

2,030,000 Gas

RPR 398#

COMPLETED

KANSASKansas Pool Name HugotonMap No. 10 map Sec. 36 Twp. 25 R. 36WWell No. 3 Kansas Masonic HomeFin-Ker

Company

FIRST REPORT

Contractor

C W L $E\frac{1}{2}$ Sec.**SECTION PLAT**2640 Ft. from N. Line Ft. from S. Line Ft. from E. Line400 Ft. from W. Line

KearnyLocation Rig up

Drilling and Remarks:

10" @ 792 WOC**RECORD**Cased in., ft.Sand Gas Oil Total Depth **PRODUCTION**1st 24 hrs. Nat. 1st 24 hrs. after shot Gas Cu. Ft.Dry Hole Abandoned

Date

JUN 12 1946 19S. J. LEWIS

Scout

KANSAS

Map No. _____ Sec. 36 Twp. 25 R. 36W

Well No. 3 Kansas Masonic Home

Fin-Ker _____ Company

COMPLETED

Contractor

C W L E 1/2 Sec.

E. 1, 3059

SECTION PLAT

2640 Ft. from N. Line

_____ Ft. from S. Line

_____ Ft. from E. Line

400 Ft. from W. Line

Kearny County

Location _____

Rig up _____

Drilling and Remarks:

7" @ 2748'

Perf.

3400 acid

2,030,000 Gas

398# RP

RECORD

Cased _____ in., _____ ft.

Sand _____

Gas _____

Oil _____

Total Depth 2254

PRODUCTION

1st 24 hrs. Nat. _____

1st 24 hrs. after shot _____

Gas _____ Cu. Ft.

Dry Hole _____

Abandoned _____

Date

OCT 16 1946

19

S. J. LEWIS

Scout