


DX 78-1 Kearny

KANSAS

Section 18 Township 25 Range 36W

Well No. #1 W. H. Johnson

Company W. B. Osborn (San Antonio)

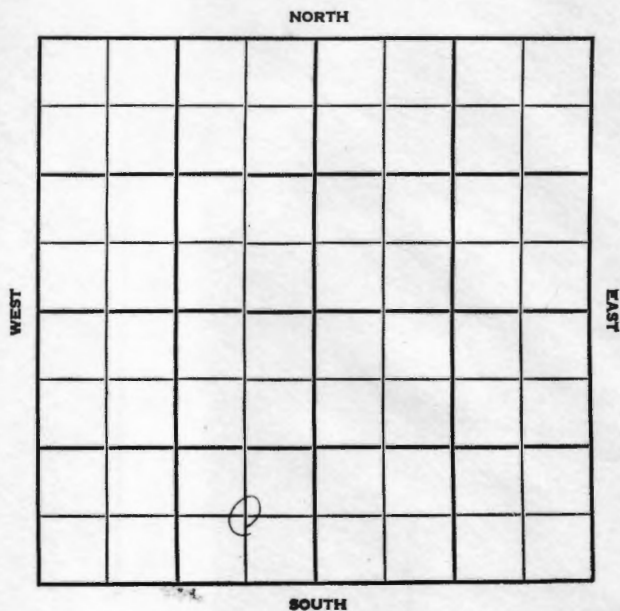

Kearny

SEC.	TWP.	R.
18	25	36W

WELL NO.

#1 W.H. Johnson

FARM

COMPANY

W. B. Osborn- (San Antonio)

CONTRACTOR

Warren Bradshaw

WILDCAT


_____ FT. FROM N. LINE

_____ FT. FROM S. LINE

_____ FT. FROM E. LINE

_____ FT. FROM W. LINE

C SE SW

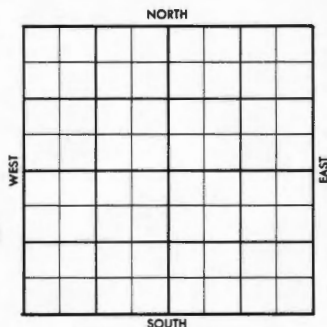

1956

ELEVATION

3042'

REPORT

5-29

To run surface pipe

6200' Arb. test

8-1

Comm. 6-7-56

13" @ 680

DST 3212-58 op 1 hr., rec. 10' mud,
BHP 540/20".DST 3908-27 op 30 min. rec. 2000' sulp.
water, BHP 1000/20".DST 5602-36 op 1 hr., rec. 2700' SW,
BHP 1540/20"

D & A

Log tops:

H. 3440'; L. 3625'; Mw. sh. 4620';

Re-Work 4780'; St.Gin. 4980';

Base M. 5490'; V. 5490'; A. 5594';

TD 6092'

ABANDONED

County Kearny Elev. 3042
 Sec. 18 Twp. 25 Rge. 36W
 Company W. B. Osborn - (San Antonio)
 Farm Name W. H. Johnson No. 1

TOPS	DEPTH	LOG	DATUM	Loc in Sec.
Ank				C SE SW
TP				
H.		3440		6200 Arb. test
Tr.				
Dg.				
BL				
L.		3625		
K. <u>H. W. sh</u>		4620		Geol.
B.K.C.				Contr.
Ce.				
C.				Warren Bradshaw
M. <u>Rework</u>		4780		
M. <u>ST GID</u>		4980		Pool
K. <u>Base M</u>		5490		Wildcat
Mz.				
Mo.				
V.		5490		
S.				
S.				
A.		5594		
R.				
PE.				
G.				
TD	6092			

ABANDONED

Date Comm.

AUG 1 1956

to run surface pipe JUN 6 '56 MIR JUN 13 '56

Spd. JUN 20 '56 6-7-56

13" @ 680 # 1680 JUN 27 '56

2995 JUL 3 '56 DST 3212-58

1hr rec 10' Md BHP 540/20"

DST 3908-27 30" rec 2000'

501p wtr BHP 1000/20 #

4322 JUL 11 '56 JUL 18 '56 DST 5602-36

1hr rec 2700' SW BHP 1540/20"

D&A (C. H. H.) JUL 25 '56

County Kearny Elev. _____
 Sec. 18 Twp. 25 Rge. 36W
 Company W. B. Osborn - (San Antonio)
 Farm Name W. H. Johnson No. 1

TOPS	DEPTH	LOG	DATUM	Loc. in Sec.
Anh.				C SE SW
Tr.				6200' Arb. test
H.				
Tr.				
Dg.				
Bl.				
L.				Geol.
K.C.				Contr.
B.K.C.				Warren Bradshaw
Ce.				Pool
C.				Wildcat
M.				
M.				
K.				
Mz.				
Me.				
V.				
S.				
S.				
A.				
R.				
Pe.				
G.				
T.D.				

FIRST REPORT

MAY 29 1936

Date Comm.

to run surface pipe

34