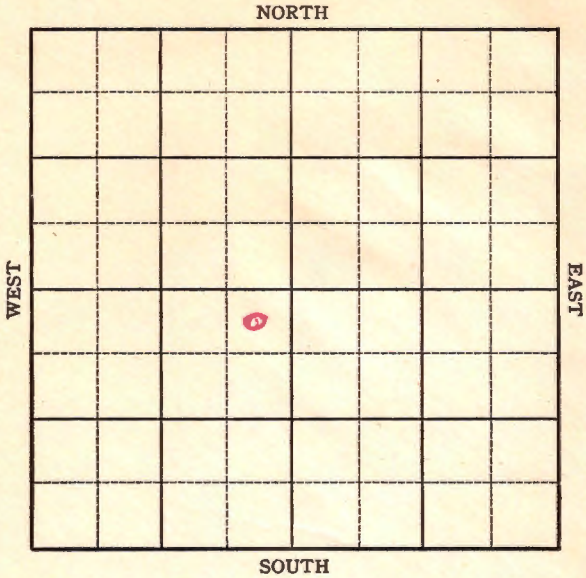


Section 26 Township 25 Range 36-WWell No. #3, RoderickCompany Fin-Ker

KANSAS

Sec. 26 Twp. 25 R. 36-WWell No. #3, Roderick Farm

Fin-Ker

Company


Hugoton Pool

330' Ft. from N. Line

Ft. from S. Line

330' Ft. from E. Line

Ft. from W. Line

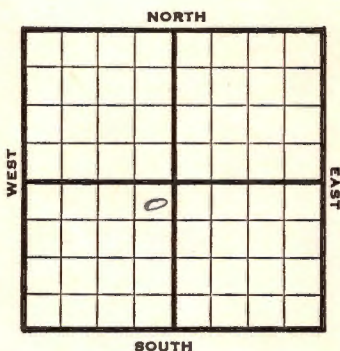

NE SW

1946 **Elev. 3035** REPORT

12/4	Drlg. 900'
12/10	Drlg 2500'
12/17	10" @ 1585'
	Drlg 2640'
1947	
1/4	TD 2735'
1/8	"
1/15	"
1/21	"
1/30	"
2/5	"
2/12	"
2/19	"
2/26	"
3/12	5" @ 2640'
	50000 Acid
	3,541,000 Gas
	396# R Pr
	TD 2735'

COMPLETED

Map No. _____ Sec. 26 Twp. 25 R. 36W

Well No. 3 Roderick

Fin-Ker _____ Company

FIRST REPORT

Contractor

NE SW

SECTION PLAT

330 _____ Ft. from N. Line

_____ Ft. from S. Line

330 _____ Ft. from E. Line

_____ Ft. from W. Line

Kearny County

Location _____

RECORD

Rig up _____

Cased _____ in. _____ ft.

Drilling and Remarks: _____

Sand _____

Gas _____

Oil _____

Total Depth _____

drlg. 900

PRODUCTION

1st 24 hrs. Nat. _____

1st 24 hrs. after shot _____

Gas _____ Cu. Ft.

Dry Hole _____

Abandoned _____

Date

DEC 4 1946 19 _____ S. J. LEWIS Scout

KANSAS

Hugoton Pool

Map No. _____ Sec. 26 Twp. 25 R. 36WWell No. 3 Roderick

Fin-Ker _____ Company

COMPLETE _____ Contractor


NE SW

B-1-3035
SECTION PLAT330 Ft. from N. Line

_____ Ft. from S. Line

330 Ft. from E. Line

_____ Ft. from W. Line

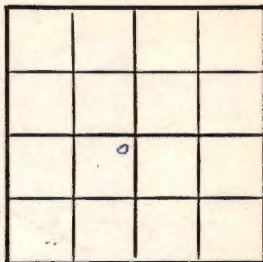

Kearny County

Location _____

Rig up _____

Drilling and Remarks:

*5" C 2640**50000 Acid**3,541,000 Gas**396 # R/R*

RECORD

Cased _____ in., _____ ft.

Sand _____

Gas _____

Oil _____

Total Depth 2795

PRODUCTION

1st 24 hrs. Nat. _____

1st 24 hrs. after shot _____

Gas _____ Cu. Ft.

Dry Hole _____

Abandoned _____

Date

MAR 12 1947 19

S. J. LEWIS Scout