

Kearny


FORM 51 IOM 12-46 PETROL

KANSAS

Section 34 Township 25 Range 36W

Well No. 5 Masonic Home

Company Fin-Ker

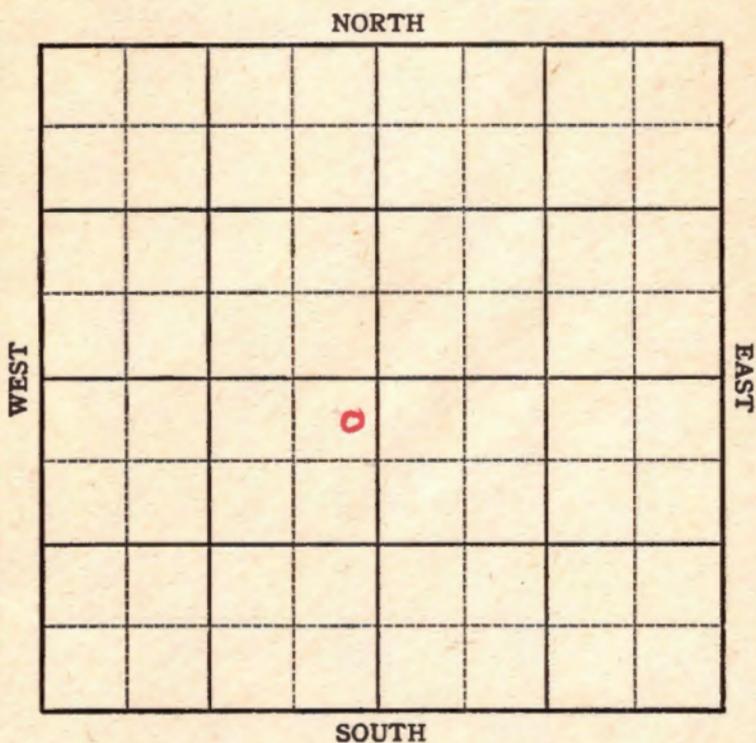

Kearny

Sec. 34 Twp. 25 R. 36-W

Well No. # 5 Masonic Home Farm

Fin-Ker Company

Hugoton Pool


300 Ft. from N. Line

_____ Ft. from S. Line

100 Ft. from E. Line

_____ Ft. from W. Line

NE SW

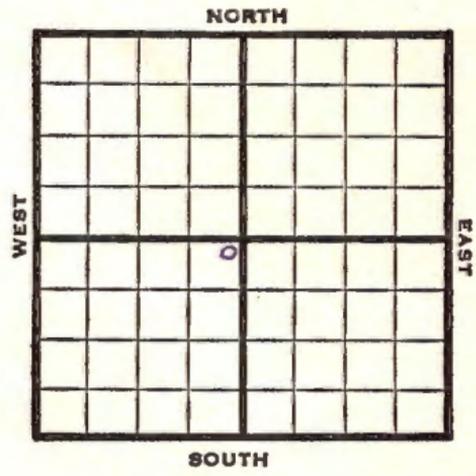

1947	Elev. 3052' REPORT
6/18	R U R
6/24	16" @ 110' Drlg. 955'
7/1	10" @ 1578' Drlg 2038'
7/8	TD 2662' 7" @ 2654' RUST
7/16	"
7/22	"
7/29	"
8/6	"
8/13	"
8/20	"
8/27	"
9/3	"
9/10	"
9/17	"

OVER OVER

1947

9/24	TD 2662'
10/1	"
10/8	"
10/15	"
10/22	"
10/29	"
11/5	"
11/12	"
11/19	"
11/25	"
12/3	7" @ 2654'

Perf.
Acid 15,000
Gas 5,041,000
R. Pr. 398#
Total Depth 2662'

COMPLETED

Hugoton Pool

Form 26 200 Bks. 10-46 Petrol
Kansas

Map No. _____ Sec. 34 Twp. 25 R. 36W

Well No. 5 Masonic Home

Fin-Ker _____ Company

COMPLETE

_____ Contractor

NE SW

E13052

SECTION PLAT

300 Ft. from N. Line

_____ Ft. from S. Line

100 Ft. from E. Line

_____ Ft. from W. Line

	4		

Kearny County

Location _____

Rig up _____

Drilling and Remarks:

7" @ 2654
Prof.
15000000'
5,041,000 Gas

298 R/B

RECORD

Cased _____ in., _____ ft.
 Sand _____
 Gas _____
 Oil _____
 Total Depth 2662

PRODUCTION

1st 24 hrs. Nat. _____
 1st 24 hrs. after shot _____
 Gas _____ Cu. Ft.
 Dry Hole _____
 Abandoned _____

Date

DEC 3 1947 19

S. J. LEWIS Scout

Map No. _____ Sec. 34 Twp. 25 R. 36W

Well No. 5 Masonic Home

Fin-Ker

Company _____

FIRST REPORT

Contractor _____

NE SW

SECTION PLAT

300 Ft. from N. Line

_____ Ft. from S. Line

100 Ft. from E. Line

_____ Ft. from W. Line

	0		

Kearny County

Location _____

Rig up _____

Drilling and Remarks:

R U R

RECORD

Cased _____ in., _____ ft.

Sand _____

Gas _____

Oil _____

Total Depth _____

PRODUCTION

1st 24 hrs. Nat. _____

1st 24 hrs. after shot _____

Gas _____ Cu. Ft.

Dry Hole _____

Abandoned _____

Date

JUN 18 1947 19

S. J. LEWIS Scout