


Section 25 Township 25 Range 37W

Well No. #1 Johnson

Company Kansas-Nebraska

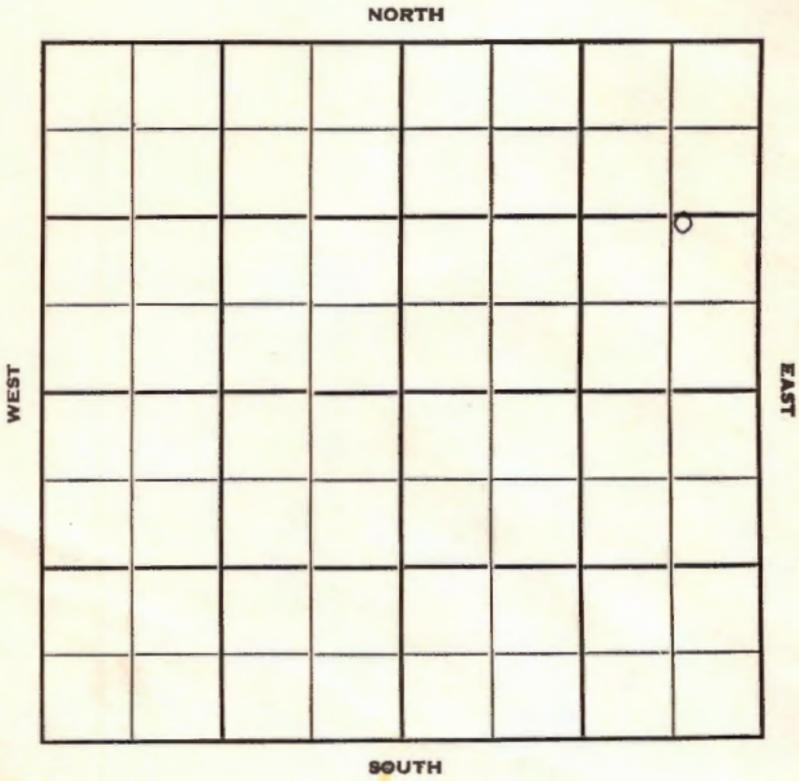

Sec. 25 Twp. 25 R. 37 W

Well No. # 1 Johnson Farm

Kansas-Nebraska Company

Contractor

Hugoton Pool


1375 Ft. from N. Line

Ft. from S. Line

640 Ft. from E. Line

Ft. from W. Line

SE NE NE

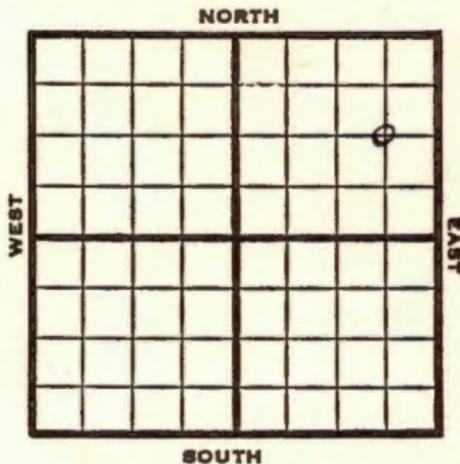

1951

Elev. 3058' REPORT

9/26

Spud 9-10-51  
10" @ 518  
TD 2650'  
7" @ 2646'

1952  
2/6

TD 2650 7" @ 2646

2/13

Spud 9-10-51  
Gas Well TD 2540  
10" @ 518 7" @ 2646  
TD 2650  
Her. 2416 Kri 2430  
Win 2470 Ft. Riley 2530  
60/2416-26 108/2430-48  
9/2474-89 120/2534-54  
180/2580-2610 Comp. 3,214,000 gas

**COMPLETED**




County Kearny State Kansas

Sec. 25 (Blk. Twp.) 25 (Sur. Rge.) 37W Map No.

Operator Kansas - Nebraska

Well No. 1 Farm Johnson

Elev. 3058 Location SE NE NE

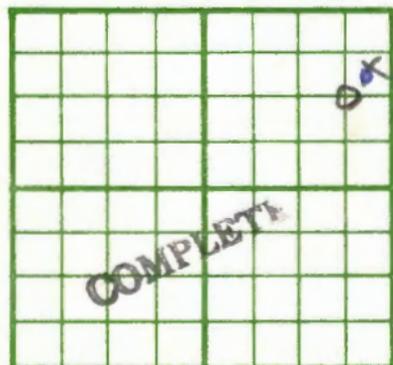

1375 Ft. From N Line NE

510 Ft. From E Line Quarter

Ist. Report

Completion FEB 13 1952

Remarks Hugoton Pool

Spudding Date 9-10-51

Drlg. Data Gas well TD 2650

10" @ 518 7" @ 2646 TD 2650

Her. 2416 Kri. 2430 Win. 2470

Ft. Riley 2530 60/ 2416-26 108/ 2430-48

9/ 2474-89 120/ 2534-54 180/ 2580-2610

Comp. 3,214,000 gas