


Section 29 Township 25 Range 37 W

Well No. # 1 Masson

Company Stanolind

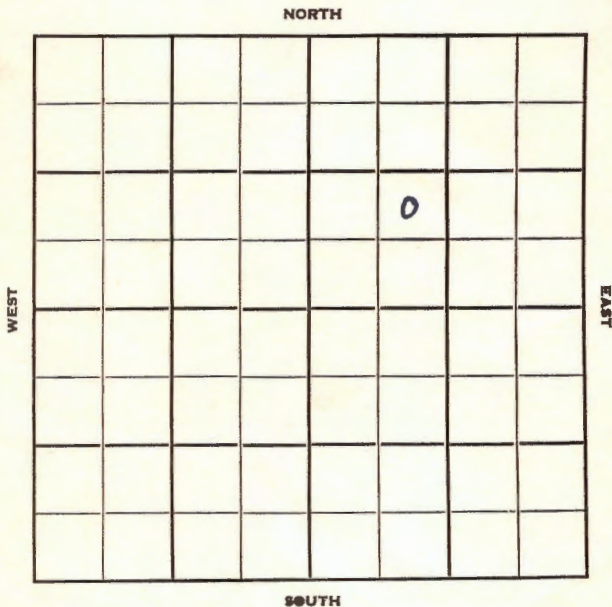

Sec. **29** Twp. **25** R. **37W**

Well No. **#1 Masson** Farm

Stanolind Company

Contractor

Ft. from N. Line

950


Ft. from S. Line

Ft. from E. Line

900

Ft. from W. Line

NE SW NE

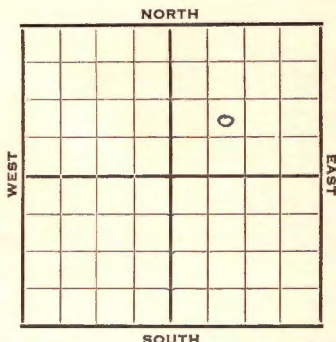

1952 Elev. 3087'

REPORT

6/11 Spud 5-27-52
8" @ 543'

Her. 2382 Win. 2444
U.Ft Riley 2492 L. Ft. Riley 2542
RTD 2562 5" @ 2542' MICT

6/18 DD 2567' 2500 A 18/2382-85
18/2387-90 60/2398-2411
54/2414-23 30/2434-39 36/2440-50
42/2455-62 60/2468-81 36/2492-98
60/2501-13 24/2515-19 24/2523-27
22,000 A

6/25 Spud 5-27-52
Gas Well TD 2567
8" @ 543 Her 2382 Win 2444
Ft. Riley 2492 L. Ft. Riley 2542
TD 2562 5" @ 2542 DD 2567
2500 A 18/2382-85 18/2387-90
60/2398-2411 54/2414-23
30/2434-39 36/2440-50 42/2455-62
60/2468-81 36/2492-98
60/2501-13 24/2515-19 24/2523-27
22,000 A Comp. 13,413,000 gas

COMPLETED

