


Kearny

KANSAS

Section 31 Township 25 Range 37 W

Well No. # 1 Owen Gas Unit

Company Stanolind

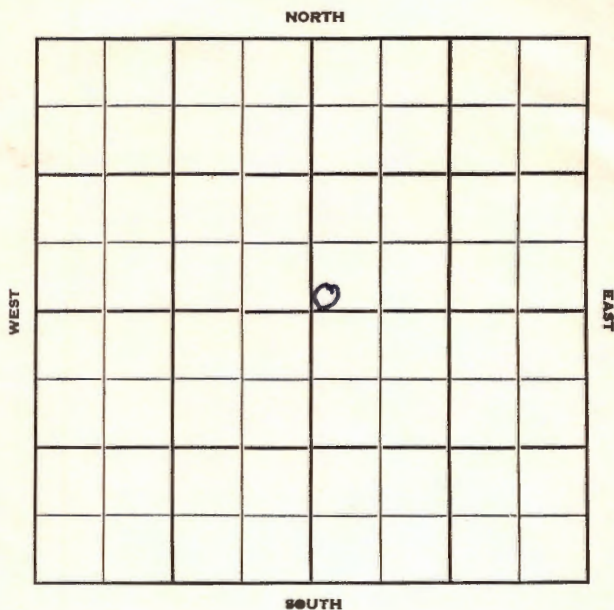

Sec. **31** Twp. **25** R. **37W**

Well No. **#1 Owen Gas Unit** Farm

Stanolind

Company

Contractor

Ft. from N. Line

150


Ft. from S. Line

Ft. from E. Line

150

Ft. from W. Line

SW NE

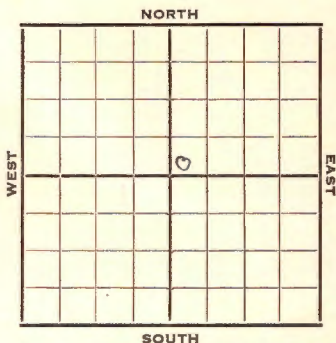

1952

Elev. 3113'

REPORT

6/11

M I R

6/18

10" @ 574

Drlg. 2305'

6/25

Her 2394

Win 2454

Up Ft. 2503

Low Ft 2554

RTD 2572 7" @ 2554'

7/2

TD 2579' 2500 A 18/2536-39
 12/2529-31 66/2511-22 66/2475-86
 24/2394-98 2500 A 48/2401-09
 24/2414-18 24/2420-24 30/2429-34
 12/2460-62 42/2466-73 24/2492-96
 2500 A 30/2503-08 2500 A
 24,000 A 1 1/4" @ 2560'

7/9

Spud 6-10-52 Gas Well

TD 2579 10" @ 574

Her 2394 Win 2454

Ft. Riley 2503 7" @ 2554 TD 2579

18/2536-39 12/2529-31 66/2511-22
 66/2475-86 24/2394-98 48/2401-09
 24/2414-18 24/2420-24 30/2429-34
 12/2460-62 42/2466-73 24/2492-96
 30/2503-08 24,000 A

Comp. 19,909,000 gas 405#

COMPLETED

County **Kearny** State **KANSAS**

Sec. **31** (Blk. Twp.) **25** (Sur. Rge.) **37W** Map No.

Operator **Stanolind**

Well No. **3** Farm **Owen Gas Unit**

Elev. **3113** Location **SW NE**

150 Ft. From **S** Line **NE**

150 Ft. From **W** Line Quarter

1st. Report **JUN 11 1952**

Completion

Remarks

Spudding Date

Drig. Data

M I R

J. G. McGEHEE

