

Section 33 Township 25 Range 37W

Well No. #1 Waechter (J)

Company Stanolind

NORTH

					0		

WEST

EAST

SOUTH

33
Sec. _____ Twp. _____ R. _____

Well No. #1 Waechter (J) Farm _____

Stanolind Company _____

Contractor _____

Hugoton Pool


800' Ft. from N. Line

Ft. from S. Line

Ft. from E. Line

800' Ft. from W. Line

SE NW SE

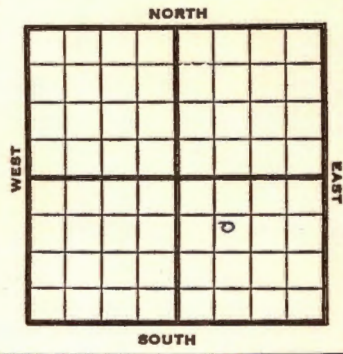

1951 Elev. 3086' REPORT

6/13
8/1

Location
 Spud 6-12-51
 Gas Well TD 2556
 10" @ 529
 7" @ 2539
 TD 2556
 Win 2434 Ft. Riley 2492
 102/2378-95 20/2400-05
 42/2410-17 96/2434-50
 156/2492-2518 24,000 A
 Comp. 9,978,000 gas 425#

COMPLETED

County **Kearny** State **Kansas**

Sec. **33** (Blk.) **25** (Sur.) **37W** Map No.

Operator **Stanolind**

Well No. **1** Farm **Waechter (J)**

Elev. Location **SE NW SE**

FIRST REPORT

800 Ft. From **N** Line **SE**

800 Ft. From **W** Line **Quarter**

1st. Report **JUN 13 1951**

Completion

Remarks

Spudding Date

Drig. Data

Location Hugoton Pool

J. E. TYRA

