


Section 20 Township 25 Range 37 W

Well No. #1 Tate

Company Stanolind

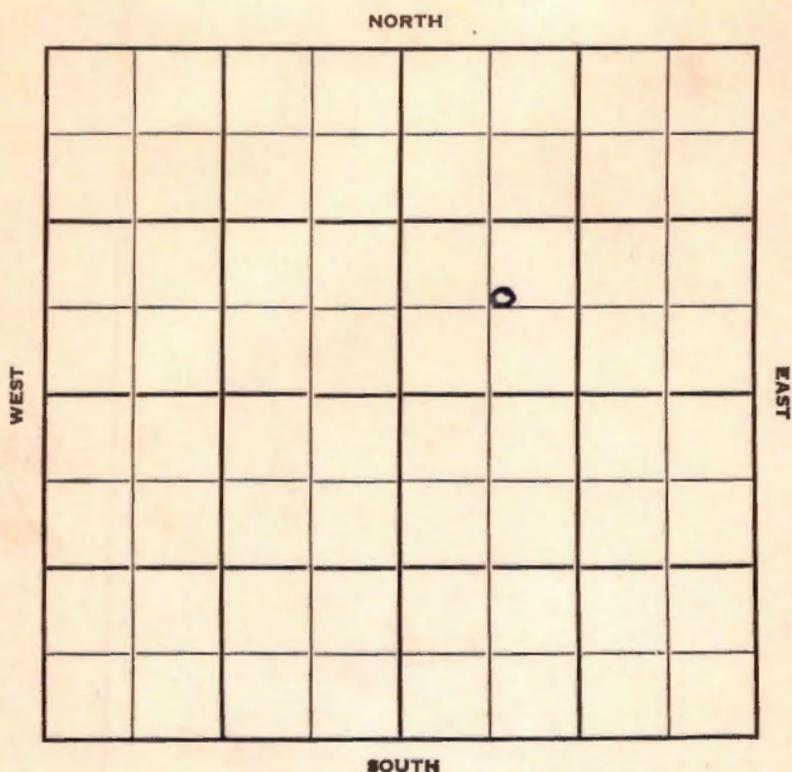

Sec. 20 Twp. 25 R. 37W

Well No. #1 Tate Farm

Stanolind Company

Hugoton Pool Contractor


Ft. from N. Line

700' Ft. from S. Line

Ft. from E. Line

700' Ft. from W. Line

C SW NE

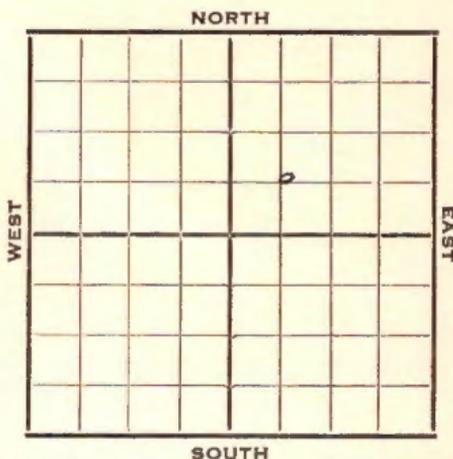

1952 Elev. 3101' REPORT

4/23 Location

4/30 "

5/7 "

5/14 "

5/21 C&P

5/28 8" @ 553 Her Krider 2396
Winfield 2453 Up Ft 2507
Low Ft 2555 RTD 2573
5" @ 2556

6/11 DD 2580 2500 A 24/ 2398-2402
90/ 2408-23 24/ 2431-35
24/2453-58 24/ 2460-64
18/ 2469-72 42/ 2477-84
30/ 2492-97 30/ 2507-12
18/ 2515-18 60/ 2524-34
42/ 2540-47 25,500 A

6/18 Spud 5-20-52
Gas well TD 2580' 8" @ 553
Her.-Kri. 2396' Win 2453'
Ft. Riley 2507' TD 2573' 5" @ 2556
DD 2580 2500 A 24/2398-2402
90/2408-23 24/2431-35 24/2453-58
24/2460-64 18/2469-72 42/2477-84
30/2492-97 30/2507-12 18/2515-18
60/2524-34 42/2540-47 25,500 A
Comp. 10,448,000 gas

COMPLETED

County **Kearny** State **Kansas**

Sec. **20** (Blk. Twp.) **25** (Sur. Rge.) **37W** Map No.

Operator **Stanolind**

Well No. **1** Farm **Tate**

Elev. **3101** Location **C SW NE**



700 Ft. From **S** Line **NE**

700 Ft. From **W** Line **Quarter**

Ist. Report **APR 23 1957**


Completion

Remarks

Spudding Date

Drig. Data **Hugoton Pool**

Location

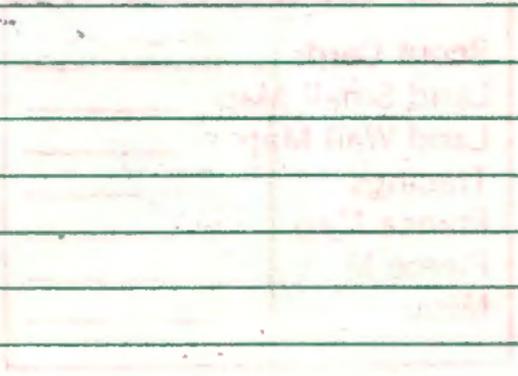

County Kearny State Kansas

Sec. 20 (Blk. 25) (Sur. 37W) Map No.

Operator Stanolind

Well No. 1 Farm Tate

Elev. 3101 Location C SW NE

| | | | | | |
|--|--|--|--|--|--|
| | | | | | |
| | | | | | |
700 Ft. From S Line NE

700 Ft. From W Line Quarter

1st. Report

Completion JUN 18 1952

Remarks Hugoton Pool

Spudding Date 5-20-52

Drlg. Data Gas well TD 2580

8" @ 553 Her.-Kri. 2396 Win. 2453

Ft. Riley 2507 TD 2573 5" @ 2556

DD 2580 2500 A 24/ 2398-2402

90/ 2408-23 24/ 2431-35 24/ 2453-58

24/ 2460-64 18/ 2469-72 42/ 2477-84

30/ 2492-97 30/ 2507-12 18/ 2515-18

60/ 2524-34 42/ 2540-47 25500 A

Comp. 10,448,000 gas

J. G. McGEHEE