


Section 23 Township 25 Range 37-W

Well No. #1 Applegate

Company W B Osborne

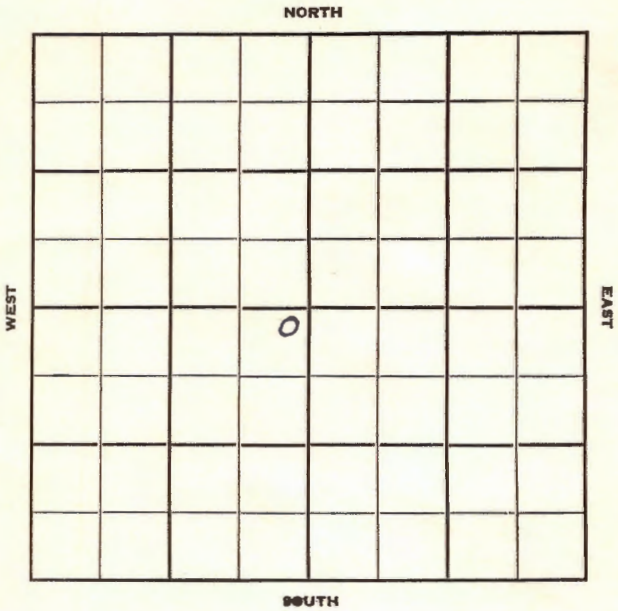

Kearny

KANSAS

Sec. 23 Twp. 25 R. 37W

Well No. #1 Applegate Farm

W. B. Osborne Company

Contractor

Hugoton Pool


150' Ft. from N. Line

Ft. from S. Line

150' Ft. from E. Line

Ft. from W. Line

NE SW

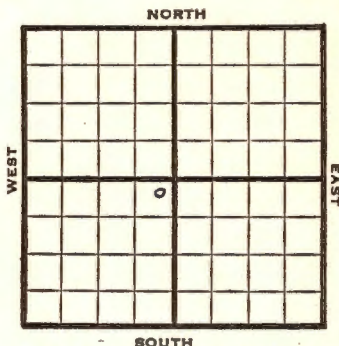

1950

REPORT

11/15

Location

1951

1/3

Spud 11-16-50

Gas Well TD 2580

10" @ 554' 7" @ 2380

TD 2430 Her. 2380-2420

Win 2440 Ft. Riley 2510

TD 2580' 3300 A Comp.

14,000,000 gas

COMPLETED

County Kearny State KansasSec. 23 (Blk. Twp.) 25 (Sur. Rge.) 37W Map No.Operator W. B. OsborneWell No. 1 Farm ApplegateElev. Location NE SW

FIRST REPORT

0

150 Ft. From N Line SW150 Ft. From E Line Quarter1st. Report NOV 15 1950

Completion

Remarks

Spudding Date

Drig. Data Hugoton PoolLocation

J. E. TYRA

J. E. TYRA