


Section 28 Township 25 Range 37W

Well No. 1 Tate

Company Stanolind & Magnolia

Hugoton

NORTH

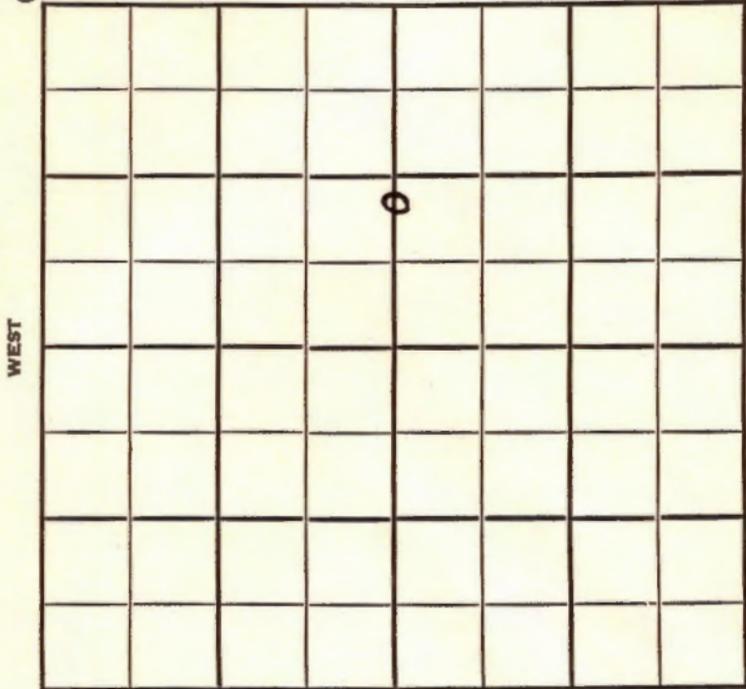

SOUTH

KANSAS

Kearney

Sec. 28 Twp. 25 R. 37W

Well No. #1 Tate Farm _____

Stanolind & Magnolia Company
Hugoton


Ft. from N. Line

1390
Ft. from S. Line

2640
Ft. from E. Line

Ft. from W. Line

C W 1/2 Sec. *Loc. ?*

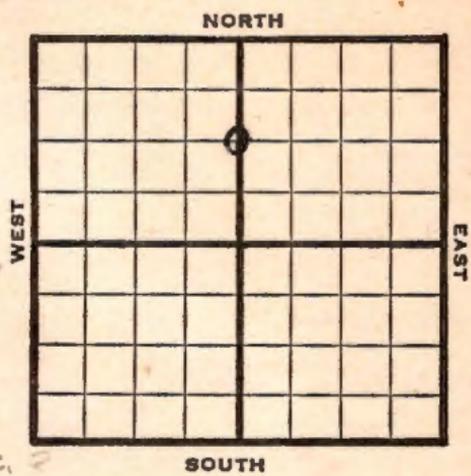

1947 **Elev. 3105'** **REPORT**

10/22	Location
10/29	10" @ 589' Drlg. 600'
11/5	TD 2415'
11/12	7" @ 2407' RUST
11/19	TD 2615' 220' of 5" Perf liner @ 2635'
11/25	16,500 acid.
12/3	7" @ 2409' 220' of 5" Perf liner @ 2615 Acid 16,500 Gas 9,205,000 Rock Pressure 430# Total Depth 2615'

COMPLETED

Hugoton

Map No. _____ Sec. 28 Twp. 25 R. 37W

Well No. 1 Tate

Stenolind & Magnolia Company

FIRST REPORT Contractor

C W $\frac{1}{2}$ Sec


SECTION PLAT

_____ Ft. from N. Line

1390 Ft. from S. Line

2640 Ft. from E. Line

_____ Ft. from W. Line

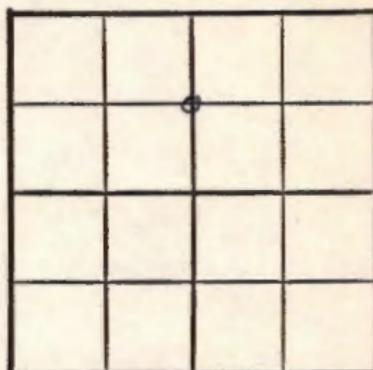

Kearny County

Location X

Rig up _____

Drilling and Remarks:

RECORD

Cased _____ in., _____ ft.

Sand _____

Gas _____

Oil _____

Total Depth _____

PRODUCTION

1st 24 hrs. Nat. _____

1st 24 hrs. after shot _____

Gas _____ Cu. Ft.

Dry Hole _____

Abandoned _____

Date

OCT 22 1947 19

S. J. LEWIS Scout

Map No. _____ Sec. 28 Twp. 25 R. 37W

Well No. 1 Tate

Stanolind & Magnolia Company

COMPLETE Contractor

C $\frac{1}{2}$ Sec.

E. 3105


SECTION PLAT

_____ Ft. from N. Line

1390 Ft. from S. Line

2640 Ft. from E. Line

_____ Ft. from W. Line

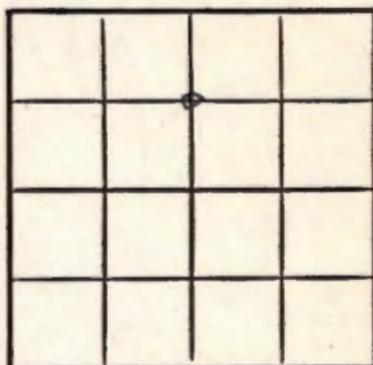

Kearny County

Location _____

Rig up _____

Drilling and Remarks:

7C 2409
220' of 5" Prof wire
@ 2665
16500 acid
9,205,000 Gas

430 R/A

RECORD

Cased _____ in., _____ ft.

Sand _____

Gas _____

Oil _____

Total Depth 2615

PRODUCTION

1st 24 hrs. Nat. _____

1st 24 hrs. after shot _____

Gas _____ Cu. Ft.

Dry Hole _____

Abandoned _____

Date

DEC 3 1947 19

S. J. LEWIS Scout