


Section 12 Township 25 Range 37-W

Well No. #1 Beymer Unit "A"

Company Stanolind
Hugoton

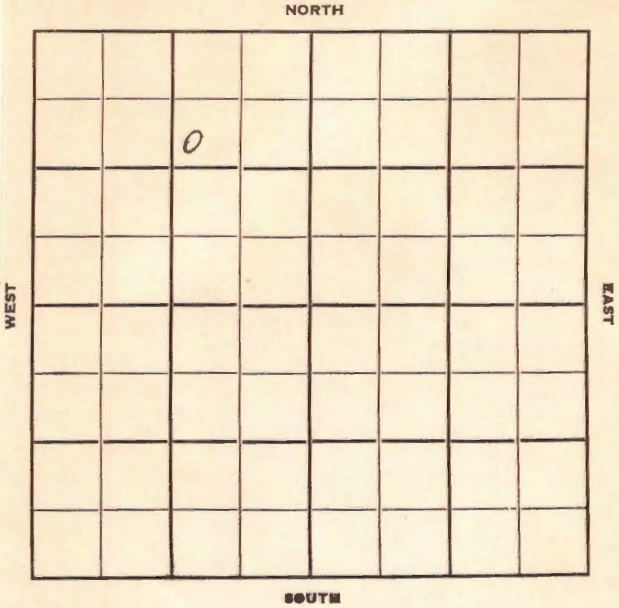

Sec. 12 Twp. 25 R. 37W

Well No. #1 Beymer Unit "A" Farm

Stanolind Company

Contractor

Hugoton Pool


1240' Ft. from N. Line

_____ Ft. from S. Line

940' Ft. from E. Line

_____ Ft. from W. Line

SW NE NW

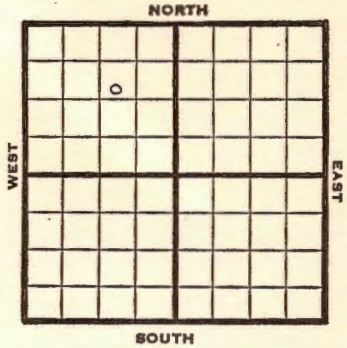

1950

Elev 3069' REPORT

3/8

Spud 3-3-50

10" @ 660'

WOC

4/5

TD 2654'

10" @ 660'

7" @ 2566'

Winfield 2458-74'

Ft Riley 2556-59'

open flow

8,100,000 CFGPD

Comp

COMPLETED

Kansas

Hugoton Pool

Map No. _____ Sec. 12 Twp. 25 R. 37W

Well No. 1 Beymer Unit "A"

Stanolind Company

Contractor

SW NE NW

SECTION PLAT

1240 Ft. from N. Line

_____ Ft. from S. Line

840 Ft. from E. Line

_____ Ft. from W. Line



Kearny County

Location _____

Rig up _____

Drilling and Remarks:

Spud 3-3-50

10" @ 660

WOC

RECORD

Cased _____ in., _____ ft.

Sand _____

Gas _____

Oil _____

Total Depth _____

PRODUCTION

1st 24 hrs. Nat. _____

1st 24 hrs. after shot _____

Gas _____ Cu. Ft.

Dry Hole _____

Abandoned _____

Date

MAR 8

1950

J. E. TYRA

19

Scout

Map No. _____ Sec. 12 Twp. 25 R. 37W

Well No. 1 Beymer Unit "A"

Stanolind

Company

Contractor

SW NE NW

E. 3069

SECTION PLAT

1240 Ft. from N. Line

_____ Ft. from S. Line

840 Ft. from E. Line

_____ Ft. from W. Line

	•		
COMPLETE			

Kearny County

Location _____

Rig up _____

Drilling and Remarks:

10" @ 660
7" @ 2566
Winfield 2458-74
7 ft Riley 2556-59
open flow
8,100,000 CF6 PD

RECORD

Cased _____ in., _____ ft.

Sand _____

Gas _____

Oil _____

Total Depth 2654

PRODUCTION

1st 24 hrs. Nat. _____

1st 24 hrs. after shot _____

Gas _____ Cu. Ft.

Dry Hole _____

Abandoned _____

Date

APP 5 1950 19

J. E. TYRA Scout