

Kearny


KANSAS

FORM 51 IOM 12-48 PETROL

Section 13 Township 25 Range 37W

Well No. #1 Johnson

Company Osborne et al
Hugoton

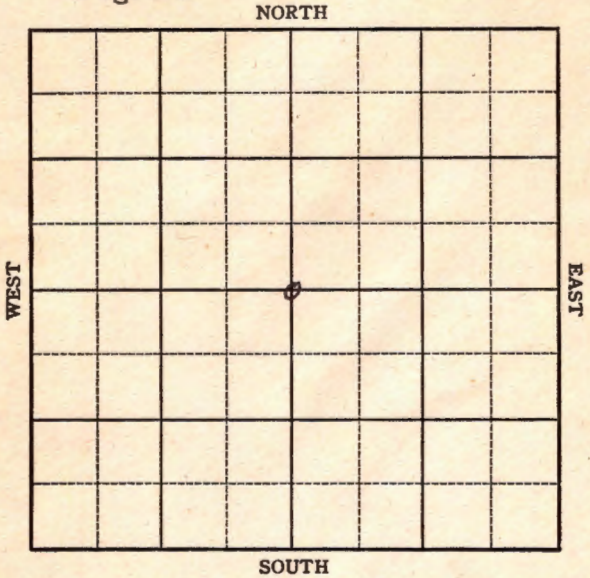

Sec. 13 Twp. 25 R. 37-W

Well No. #1 Johnson Farm

Osborne etal Company

Hugoton Pool


2640 Ft. from N. Line

 Ft. from S. Line

2640 Ft. from E. Line

 Ft. from W. Line

C Sec.

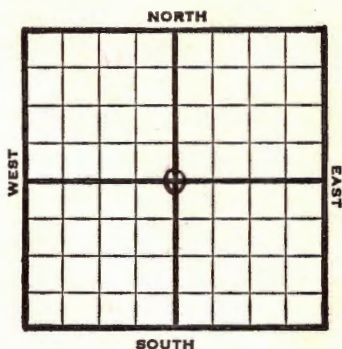

1947

Elev. 3044'

REPORT

7/2 Location

7/8 9" @ 543'
WOC

7/16 TD 2600'
5" @ 2595'
RUST

7/22 "

7/29 TD 2600'

8/6 "

8/13 216 shots 2330-66
96 " 2892-2408
164 " 2442-2470
252 " 2490-2532
16000 Acid

8/20 " "

8/27 " "

9/3 " "

9/10 " "

9/17 " "

9/24 " "

10/1 " "

10/8 " "

OVER

1947

10/15 5" @ 2595

Perf 33,000 Acid

18,300,000 Gas

TD 2600

412# RPr.

COMPLETED

p No. 2 Sec. 13 Twp. 25 R. 37W

Well No. 1 Johnson

Osborne et al. Company

CORRECTION Contractor

C Sec.


SECTION PLAT

2640 Ft. from N. Line

 Ft. from S. Line

2640 Ft. from E. Line

 Ft. from W. Line

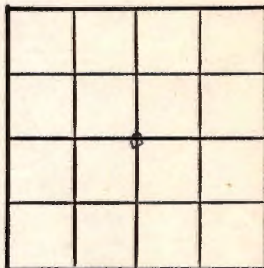

Kearny County

Location

Rig up

Drilling and Remarks:

Reported

14-25-37W

RECORD

Cased in., ft.

Sand

Gas

Oil

Total Depth

PRODUCTION

1st 24 hrs. Nat.

1st 24 hrs. after shot

Gas Cu. Ft.

Dry Hole

Abandoned

Date

JUL 2 1947 19

S. J. LEWIS Scout

26 200 Bks. 10-46 Petrol
KANSAS

Hugoton Pool

Map No. 0 Sec. 14 Twp. 25 R. 37W

Well No. 1 Johnson

Osborne et al. Company

FIRST REPORT Contractor

C Sec.


SECTION PLAT

2640 Ft. from N. Line

 Ft. from S. Line

2640 Ft. from E. Line

 Ft. from W. Line

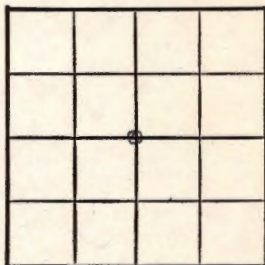

Kearny County

Location X

Rig up

Drilling and Remarks:

RECORD

Cased in., ft.

Sand

Gas

Oil

Total Depth

PRODUCTION

1st 24 hrs. Nat.

1st 24 hrs. after shot

Gas Cu. Ft.

Dry Hole

Abandoned

Date

APR 2 1947 19

S. J. LEWIS

Scout

Map No. 0 Sec. 13 Twp. 25 R. 37W

Well No. 1 Johnson

Osborne et al. Company

COMPLETE Contractor

C Sec.


E1.8044
SECTION PLAT

2640 Ft. from N. Line

 Ft. from S. Line

2640 Ft. from E. Line

 Ft. from W. Line

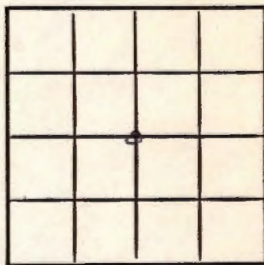

Kearny County

Location

Rig up

Drilling and Remarks:

5' 0.2598'

Prof.

23000 acid

18,300,000 Gas

412# R/P

RECORD

Cased in., ft.

Sand

Gas

Oil

Total Depth 2600

PRODUCTION

1st 24 hrs. Nat.

1st 24 hrs. after shot

Gas Cu. Ft.

Dry Hole

Abandoned

Date

OCT 15 1947 19 S. J. LEWIS Scout