


Section 6 Township 25 Range 37WWell No. #1 HeintzCompany Champlin Ref.

NORTH

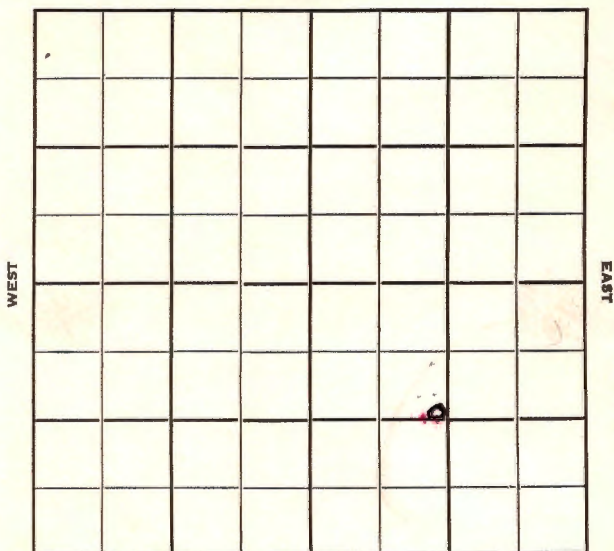

SOUTH

Kearny

Sec. 6 Twp. 25 R. 37W

Well No. #1 Heintz Farm ☒

Champlin Ref. Company

Contractor


 Ft. from N. Line

1352' Ft. from S. Line

1400' Ft. from E. Line

 Ft. from W. Line

SE NW SE

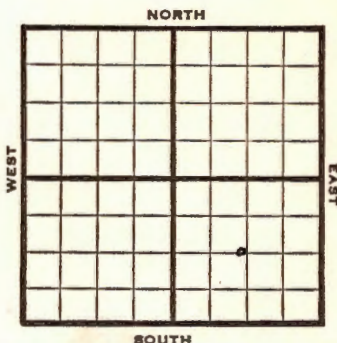

1951

Elev. 3150'

REPORT

1/24 Location

4/18

Spud 2-3-51

Gas Well TD 2626

10" @ 139

Her. 2409 Krider 2438

Win. 2488 Towanda 2548'

Ft. Riley 2591

7" @ 2623' TD 2626

CO to 2619

156/2592-2618 2500 A 102/2548-62

150/2484-2509 174/2428-57

15,000 A 72/2409-21 28,000 A

Comp. 958,000 gas 384#

COMPLETED

County **Kearny** State **Kansas**Sec. **6** (Blk.) **25** (Sur.) **37W** Map No.Operator **Champlin Ref.**Well No. **1** Farm **Heintz**Elev. Location **SE NW SE**

FIRST REPORT

0

1352 Ft. From **S** Line **SE****1400** Ft. From **E** Line Quarter1st. Report **JAN 24 1951**

Completion


Remarks

Spudding Date

Drlg. Data

Location**J. E. TYRA**

County Kearny State Kansas
 Sec. 6 (Blk. 25 (Sur. 37W Map No.)
 Operator Champlin Ref.
 Well No. 1 Farm Heintz
 Elev. 3150 Location SE NW SE

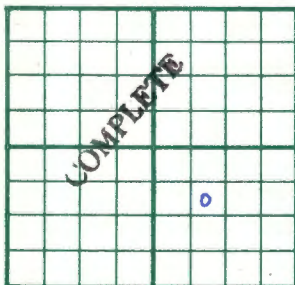

1352 Ft. From S Line SE
1400 Ft. From E Line Quarter

1st. Report

Completion APR 18 1951

Remarks

Spudding Date 2-3-51

Drlg. Data Gas well TD 2626

10" @ 139 Her. 2409 Krider 2428

Win. 2488 Towanda 2548 Ft. Riley 2592

7" @ 2623 TD 2626 CO to 2619

156/ 2592-2618 2500 A 102/ 2548-62

150/ 2484-2509 174/ 2428-57 15000 A

72/ 2409-21 28000 A

Comp. 958,000 gas 384#

J. E. TYRA