


Section 15 Township 25 Range 37W

Well No. 1 Waechter Gas Unit "M"

Company Stanclind

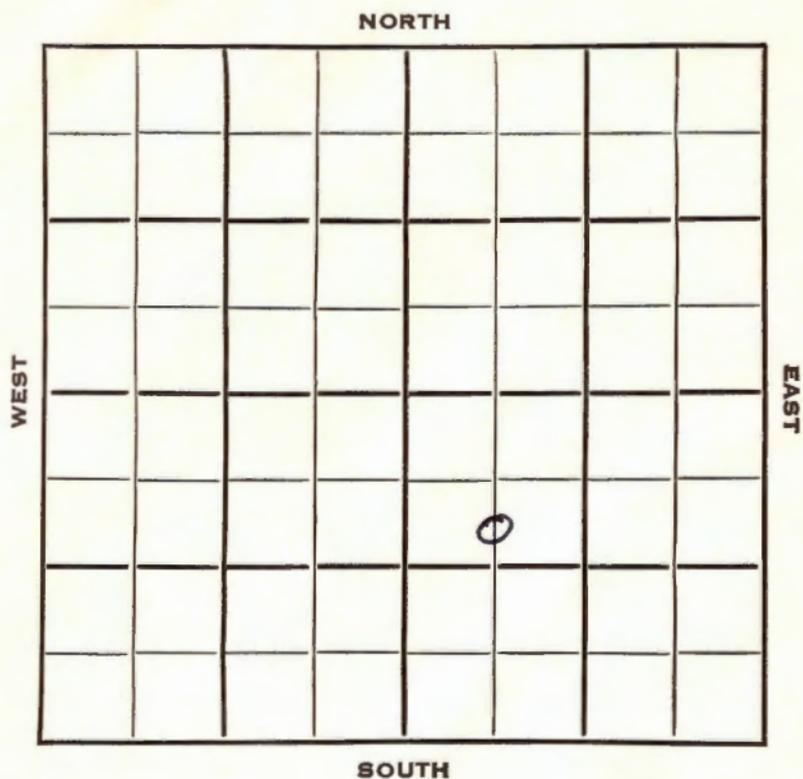

Kearny

KANSAS


|      |      |       |
|------|------|-------|
| SEC. | TWP. | R.    |
| 15   | 25   | 37W ✓ |

WELL NO. #1 Waechter Gas Unit "M" FARM

COMPANY Stanolind

CONTRACTOR

950 \_\_\_\_\_ Ft. from N. Line  
 \_\_\_\_\_ Ft. from S. Line  
 \_\_\_\_\_ Ft. from E. Line  
 640 \_\_\_\_\_ Ft. from W. Line

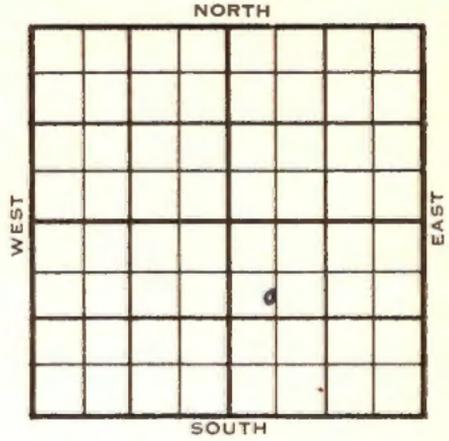

C S L NW SE

|      |           |        |
|------|-----------|--------|
| 1953 | ELEVATION | REPORT |
|      | 3055'     |        |

12/30 Location  
 1954  
 1/6 8" @ 527' w/450 sks  
 1/27 Spud 1-2-54  
 Gas Well  
 TD 2565'  
 8" @ 527'  
 Her 2359, Win 2420', Ft. Riley 2470'  
 TD 2565  
 5" @ 2519  
 CO to 2565  
 Frac, 4500 A  
 132/2476-98, 12/2470-72, 24/2452-56,  
 24/2444-48, 30/2433-38, 48/2420-28,  
 36/2394-2400, 18/2390-93, 48/2376-84,  
 48/2366-74, 12/2362-64, 12/2358-60  
~~3-frac~~  
 3-frac, 8000A  
 Comp. 7,794,000 gas, 384#

**COMPLETED**



County Kearny State Kansas

Sec. 15 (Blk. 25) (Sur. 37W) Map No. 25

Operator Stanolind

Well No. 1 Farm Waechter Gas Unit "M"

Elev. 3055 Location C S L NW SE



950 Ft. From N Line SE

640 Ft. From W Line Quarter

1st. Report

Completion JAN 27 1954

Remarks

Spudding Date 1-2-54

Drlg. Data Gas well TD 2565

8" @ 527 Her. 2359 Win. 2420

Ft. Riley 2470 TD 2565 5" @ 2519

C0 to 2565 frac 4500 A 132/ 2476-98

12/ 2470-72 24/ 2452-56 24/ 2444-48

30/ 2433-38 48/ 2420-28 36/ 2394-2400

18/ 2390-93 48/ 2376-84 48/ 2366-74

12/ 2362-64 12/ 2358-60 3-frac 8000 A

Comp. 7,794,000 gas 384#