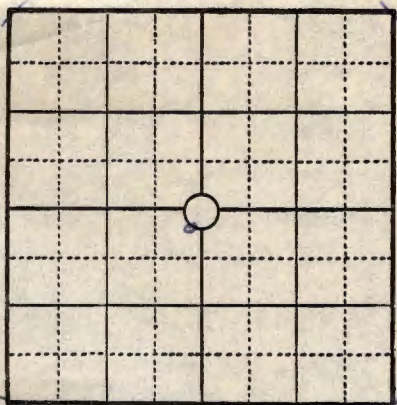


LOCATION NOTICE

TULSA, OKLA., September 1, 19 48WELL NO. 1 ON H. A. Smalley "C" FARM

WILL BE AS FOLLOWS:

2740

FEET FROM NORTH LINE

FEET FROM EAST LINE

FEET FROM SOUTH LINE

2540

FEET FROM WEST LINE

IN 411 SEC. 2 TWP. 25S RANGE 30EKearny COUNTY, STATE OF KansasREMARKS: M.G.P.C. - 75% Glenn Smith - 25%Lloyd Snyder - Dist. Supt.A. E. Johnson - ForemanSIGNED A. E. Pierce

COPIES TO

MR. KEENTZ McDowell

DISTRICT SUPT.

ACCOUNTING DEPT.

☒ SCOUTING DEPT.

GEOLOGICAL DEPT.

PIPE LINE DEPT.

MATERIALS DEPT.

RENTAL DEPT.

LEGAL DEPT.

TAX DEPT.

ENGINEERING DEPT.

LEASE INVENTORY

CLAIM DEPT.

FILE

Drilling Contractor:

Noble Drilling Corporation
Stanolind Building
Tulsa, Oklahoma

Leo Austin
J. W. Basore

Glenn Smith

DRILLING WELL COMPLETION REPORT

Well No. 1 Farm Name H. J. "Valley" "G"
Date completed Oct. 12, 1948
Description All Sec. 2-253-357
County Kearney , State Kansas
Initial production _____ bbls. Total depth 2500 feet
Initial volume 4,665,000 cu. ft. _____ lbs. rock pressure
Pipe Line Company _____
Gas Company _____
Remarks: MGPO - 75%
Blenn Smith - 25%

A. E. Flores
W

Mr. Keontz McDowell
Accounting Dept. 3
Scouting Dept.
Geological Dept.
Pipe Line Dept.
Materials Dept.
Rental Dept.
Legal Dept.
Mr. Leo Meyer
Engineering Dept.
Lease Inventory
Mr. Leo Austin
File