

KANSAS


Kearny


Section 2 Township 25 Range 38W

Well No. 1 H.A. Smalley "C"

Company Mid-Continent Petroleum

Hugoton Pool

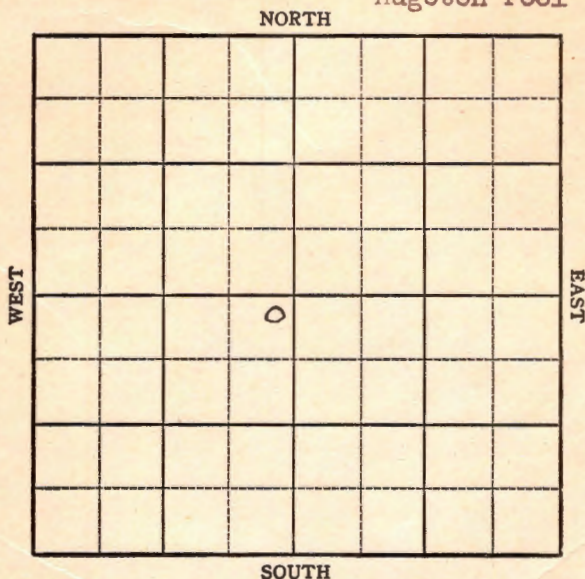

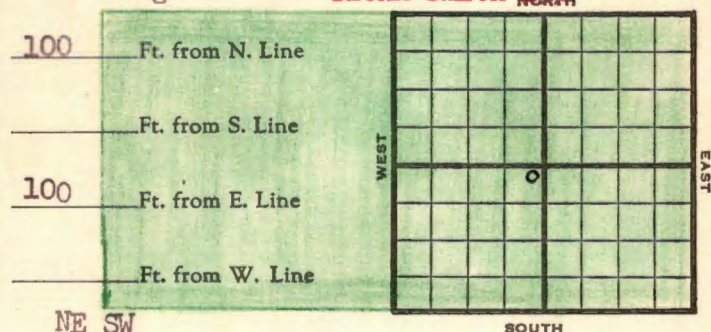Sec. 2 Twp. 25 R. 38WWell No. 1 H.A. Smalley "C" FarmMid-Continent Pet. 75% CompanyHugoton Pool Glenn Smith 25%

1948	Elev. 3132'	REPORT
		2675' test
8/25	Location	
9/3	2740' fr N & 2540' fr W lines RUR	(P R)
9/7	Spudded 9-6-48. Drlg 592'	"
9/8	Spudded 9-6-48. Set 8-5/8" csg w/ 350 sx. WOC. TD 592'	"
9/1	Set 581 ft . of 8-5/8" csg @ 588'. Drilling at 1460'	(D R)
9/10	Drilling 2120'	"
9/13	Set 5 1/2" csg @ 2546' w/ 375 sx TD 2560'	"
9/14	WOC. NR. 2560'	"
9/15	"	"
9/16	WOC.	"
9/17	WOC	"
9/20	WO Cable tools. TD 2560'	"
9/21	Waiting on cable tools.	"
9/22	Waiting on cable tools	"
9/23	Waiting on cable tools.	"
9/24	RU cable tools . TD 2560'	"

OVER

1948

9/27	Acidized with 3500 gals. $\frac{1}{2}$ million gas @ 2484'-2516' (First zone)	(D R)
9/28	Cleanin out after acidizing.	"
9/29	Perf. Winfield 87 shots 2434'-63' Krider 2396' Towards 2484' Acidized with 500 gals. Windfield 2434' 700,000 cu. ft. gas. Herrington 2385' Perf. Harrington & Crider Ft. Riley 2559' 2385'-2412' with 78 shots Acidized with 1000 gals. 1,100,000 cu. ft. gas. Re-acidized with 3000 gals. 7 AM today.	"
10/1	Acidized with 8000 gal. Blowing 1,900,000 cu. ft. gas this morning.	"
10/4	Testing. TD 2560'	"
10/5	Testing. TD 2560'	"
10/6	Testing.	"
10/7	Testing.	"
10/8	Testing. TD 2560'	"
10/11	Testing.	"
10/12	Comp. 10-12-48 4665 MFC. gas per day.	"
10/13	"	"
10/13	5 $\frac{1}{2}$ " @ 2550' Perf. 19,000 acid Gas 4,665,000 R. Pr. 420# TD 2560'	

COMPLETED

Map No. _____ Sec. 2 Twp. 25 R. 38W

Well No. 1 H. A. Smalley "C"

Mid-Continent Petroleum Company

COMPLETE

Contractor

NE SW

E. 13132


SECTION PLAT

100 Ft. from N. Line

_____ Ft. from S. Line

100 Ft. from E. Line

_____ Ft. from W. Line

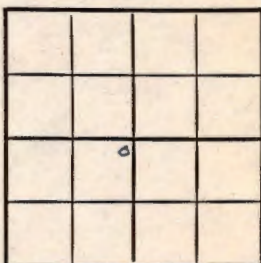

Kearny County

RECORD

Location _____

Cased _____ in., _____ ft.

Rig up _____

Sand _____

Drilling and Remarks:

Gas _____

5 1/2" C 2550

Oil _____

Perf.

Total Depth 2550

190000000

PRODUCTION

4,645,000 Cu

1st 24 hrs. Nat. _____

1st 24 hrs. after shot _____

Gas _____ Cu. Ft.

Dry Hole _____

Abandoned _____

420 R/A

Date

OCT 13 1948

19

S. J. LEWIS

Scout

Kearny County Kansas State
Map No. _____ Sec. 2 Twp. 25 R. 38W

Well No. 1 H. A. Smalley "C"

Mid-Continent Petroleum Company

FIRST REPORT

Contractor _____

NE SW


SECTION PLAT

100 Ft. from N. Line

_____ Ft. from S. Line

100 Ft. from E. Line


_____ Ft. from W. Line

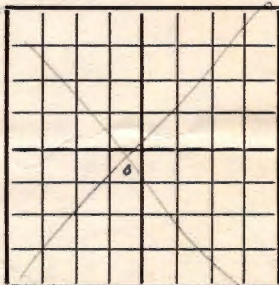

Hugoton Pool

Remarks: _____

Location _____

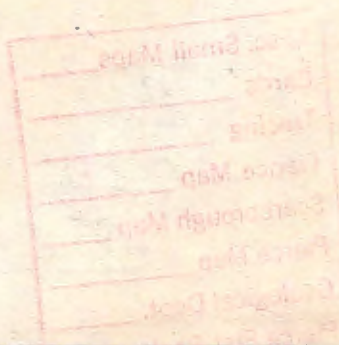

Date
AUG 25 1948

Scout S. J. LEWIS