


Section 34 Township 25 Range 38W

Well No. #1 Max Cohen "R"

Company Stanolind

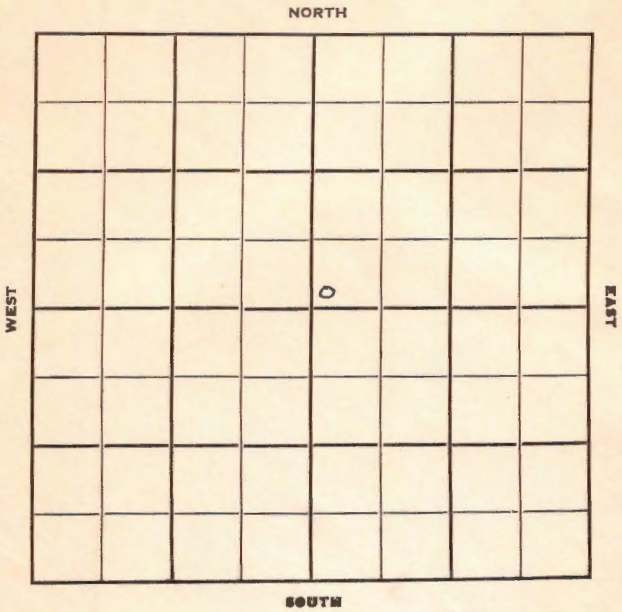

Sec. 34 Twp. 25 R. 38W ✓

Well No. #1 Max Cohen "B" Farm

Stanolind Company

Noble Drlg. - Contr. Contractor

Hugoton Pool


_____ Ft. from N. Line

150' Ft. from S. Line

_____ Ft. from E. Line

150' Ft. from W. Line

SW NE

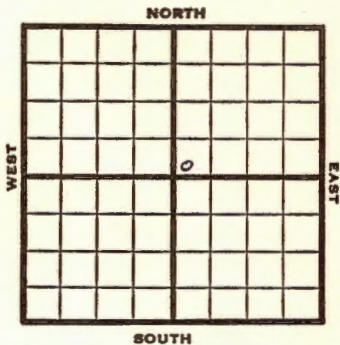

1951 **Elev. 3217** REPORT

8/15 Location

9/12 Spud 8-25-51
 Gas Well TD 2640
 10" @ 606
Her. 2448 Win. 2503
Ft. Riley 2568
 7" @ 2624 TD 2640
 156/2672-98 60/2610-20
 144/2503-27 45/2535-42
 120/2453/73 30/2476-81
 30/2486-91 25,500 A
 Comp. 23,360,000 gas 420#

COMPLETED

