

KANSAS


Kearny

FORM 51 IOM 12-46 PETROL

Section 36 Township 25 Range 38W

Well No. 1 Beaty

Company Stanolind

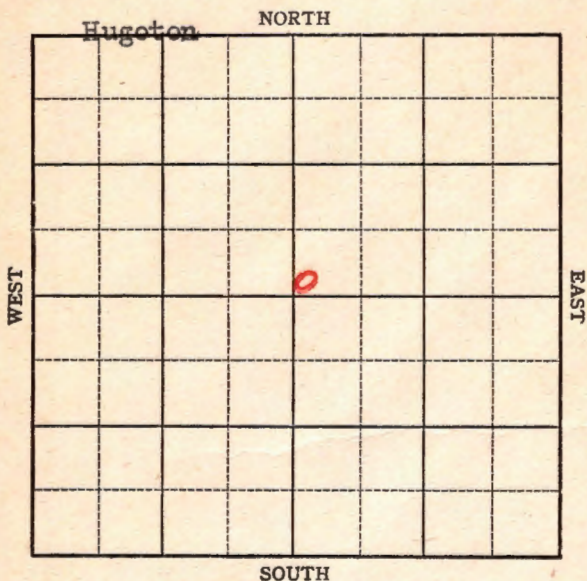

KANSAS

Kearny

Sec. 36 Twp. 25 R. 38W

Well No. #1 Beaty Farm

Stanolind Company

Hugoton


 Ft. from N. Line

50 Ft. from S. Line

 Ft. from E. Line

50 Ft. from W. Line

SW NE

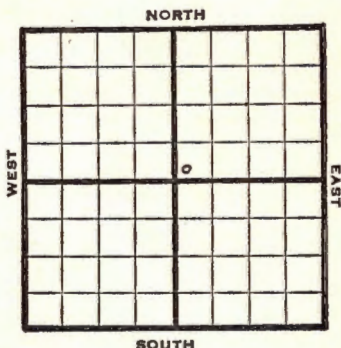

1947 **Elev. 3112' REPORT**

8/6	RUR
8/13	8" @ 566' Drlg. 1593'
8/20	TD 2565' 5" @ 2531' RUST
8/27	TD 2575' - 3000acid 180 shots. 2480-2510' 84 shots. 2432-46'
9/3	"
9/10	5" @ 2531' 15,000 acid 12,290,000 Gas 400# R. Pr. TD 2575'

COMPLETED

Map No. _____ Sec. 36 Twp. 25 R. 38W

Well No. 1 Beaty

Stanolind

Company

~~FIRST REPORT~~

Contractor

SW NE

SECTION PLAT

_____ Ft. from N. Line

50 _____ Ft. from S. Line

_____ Ft. from E. Line

50 _____ Ft. from W. Line

Kearny County

Location _____

Rig up _____

Drilling and Remarks:

RUR

RECORD

Cased _____ in., _____ ft.

Sand _____

Gas _____

Oil _____

Total Depth _____

PRODUCTION

1st 24 hrs. Nat. _____

1st 24 hrs. after shot _____

Gas _____ Cu. Ft.

Dry Hole _____

Abandoned _____

Date

AUG 6 1947 19 S. J. LEWIS Scout

Map No. 0 Sec. 36 Twp. 25 R. 38W

Well No. 1 Beaty

Stanolind Company

COMPLETE

Contractor

SW NE


E. 3/12
SECTION PLAT

 Ft. from N. Line

50 Ft. from S. Line

 Ft. from E. Line

50 Ft. from W. Line

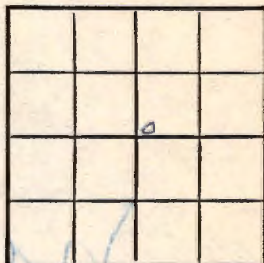

Kearny County

Location

Rig up

Drilling and Remarks:

5' 10258/

15000 acid

12,290,000 gal

400 # R/L

RECORD

Cased in., ft.

Sand

Gas

Oil

Total Depth 2575

PRODUCTION

1st 24 hrs. Nat.

1st 24 hrs. after shot

Gas Cu. Ft.

Dry Hole

Abandoned

Date

SEP 10 1947

19

S. J. LEWIS

Scout