


Kearny

KANSAS

Section 11 Township 25 Range 38 W

Well No. #1 Dole Gas Unit C

Company Stanolind

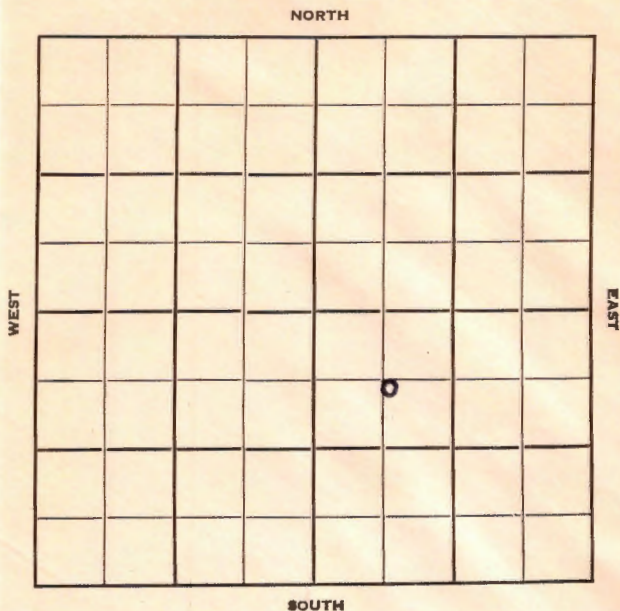

Kearny

KANSAS ✓

Sec. 11 Twp. 25 R. 38WWell No. #1 Dole Gas Unit C FarmStanolind Company

Contractor


700' Ft. from N. Line

Ft. from S. Line

Ft. from E. Line

700' Ft. from W. Line

C NW SE

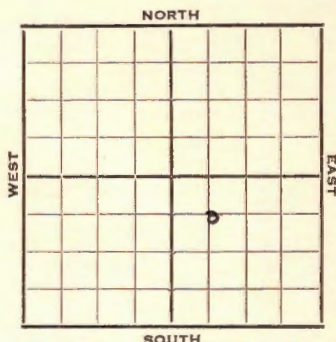

1952

Elev. 3093'

REPORT

4/30

Location

5/7

"

5/14

"

5/21

"

5/28

RTR

6/11

8" @ 494

Her 2322

Win 2366

Up Ft 2435

Low Ft 2488

RTD 2524 5" @ 2488 CO 2524

2500 A

6/18

78/2322-35

72/2340-42

104/2376-90

36/2456-62

48/2466-74

21,000 A

6/25

NR

7/2

Spud 5-26-52

Gas well TD 2524' 8" @ 494

Her. 2322' Win. 2366' Ft. Riley 2435

TD 2524' 5" @ 2488 CO to 2524'


2500 A 78/2322-35 72/2340-52

104/2376-90 36/2456-62 48/2466-74

21,000 A

Comp. 13,690,000 gas 390#

COMPLETED

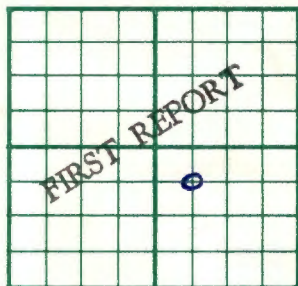County Kearny State KansasSec. 11 (Blk.) 25 (Sur.) 38W Map No.Operator StanolindWell No. 1 Farm Dole Gas Unit CElev. Location C NW SE700 Ft. From N Line SE700 Ft. From W Line Quarter1st. Report APR 30 1952


Completion

Remarks

Spudding Date

Drlg. Data

Location

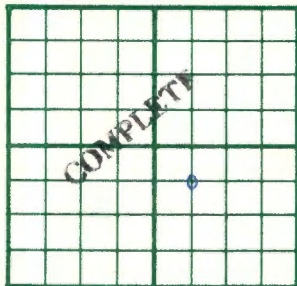County Kearny State KansasSec. 11 (Blk.) 25 (Sur. Rge.) 38W Map No.Operator StanolindWell No. 1 Farm Dale Gas Unit "C"Elev. 3093 Location C NW SE700 Ft. From N Line SE700 Ft. From W Line Quarter

1st. Report

Completion JUL 2 1952

Remarks

Spudding Date 5-26-52Drilg. Data Gas well TD 25248" @ 494 Her. 2322 Win. 2366Ft. Riley 2435 TD 2524 5" @ 2488C0 to 2524 2500 A 78/ 2322-3572/ 2340-52 104/ 2376-90 36/ 2456-6248/ 2466-74 21000 AComp. 13,690,000 gas 390#

J. G. McGEHEE