

KANSAS

Rearny

Section 4 Township 25 Range 38W

Well No. 1 Ben Strobridge

Company Mid-Continent Pet.

Hugoton

NORTH

					0		

WEST

EAST

SOUTH


HOT FILE

Kearney 38W

Sec. 4 Twp. 25S R. _____

Well No. #1 Ben Strobridge Farm
 Mid-Cont. Pet. Corp. (Operator) Company

_____ Ft. from N. Line
 100' _____ Ft. from S. Line
 _____ Ft. from E. Line
 900' _____ Ft. from W. Line
 SE SW NE

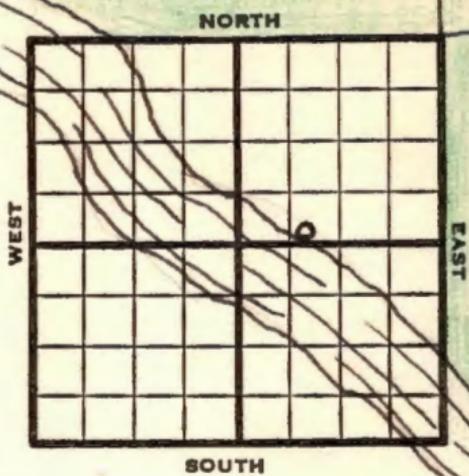

Elev 3109' REPORT

9/23	Location Notice.	
9/23	MIT	
9/26	Spud 9-23-49 Set 525' of 8-5/8" csg @ 532' w/350 sx.	
9/27	Drlg. 1730'	(DR)
9/28	Drlg. 2490'	(DR)
9/29	TD 2490' No report.	(DR)
9/30	Set 5 1/2" csg @ 2478' w/700 sx	(DR)
10/3	WOC.	"
10/4	WOC.	"
10/5	Waiting on cable tools.	"
10/6	Waiting on cable tools.	"
10/7	Waiting on cable tools.	"
10/10	Moving in cable tools.	"
10/11	Rigging up cable tools.	"
10/12	Drilling cement.	"
10/13	No report.	"
10/14	Acidizing and perforating.	"
10/17	Comp. 10-17-49 2 1/2 million cu. ft. gas per day.	"
10/12	<u>From Drilling Report</u> Herington 2325' Krider 2337' Winfield 2381' Tonwanda 2438' Ft Riley 2478'	

OVER

1949

10/19 3000 acid 2477-2520'
64 shots 2437-53 2000 acid
68 shots 2381-98 2000 acid
100 shots 2324-49 2000 acid
14,000 acid all zones
2,670,000 Gas

10/26 "

11/1 "

11/9 "

11/16 TD 2520'
5"@ 2478'
Perf 14000 acid
2,670,000 Gas
387# R Pr.
Comp

COMPLETED

Map No. _____ Sec. 4 Twp. 25 R. 38W

Well No. 1 Ben Strobridge

Mid-Continent Petroleum _____ Company

Noble Drlg. _____ Contractor

SE SW NE

FIRST SECTION PLAT

_____ Ft. from N. Line

100 Ft. from S. Line

_____ Ft. from E. Line

900 Ft. from W. Line

Kearny County

Location _____

Rig up _____

Drilling and Remarks:

8 5/8" @ 532

375 sacks

drlg. 1530

RECORD

Cased _____ in., _____ ft.

Sand _____

Gas _____

Oil _____

Total Depth _____

PRODUCTION

1st 24 hrs. Nat. _____

1st 24 hrs. after shot _____

Gas _____ Cu. Ft.

Dry Hole _____

Abandoned _____

Date

SEP 28 1949 19

S. J. LEWIS

Scout

Map No. _____ Sec. 4 Twp. 25 R. 38W

Well No. 1 Ben Strobridge

Mid-Continent Petroleum Company

COMPLETE

Contractor

SE SW NE

R 13109

SECTION PLAT

_____ Ft. from N. Line

100 Ft. from S. Line

_____ Ft. from E. Line

900 Ft. from W. Line

Kearny County

Location _____

Rig up _____

Drilling and Remarks:

5" 2 475

Prof

1400000 cu ft

2,670,000 cu ft

*387 * R 13*

RECORD

Cased _____ in., _____ ft.

Sand _____

Gas _____

Oil _____

Total Depth 2530

PRODUCTION

1st 24 hrs. Nat. _____

1st 24 hrs. after shot _____

Gas _____ Cu. Ft.

Dry Hole _____

Abandoned _____

Date

NOV 16 1949

19

S. J. LEWIS

Scout