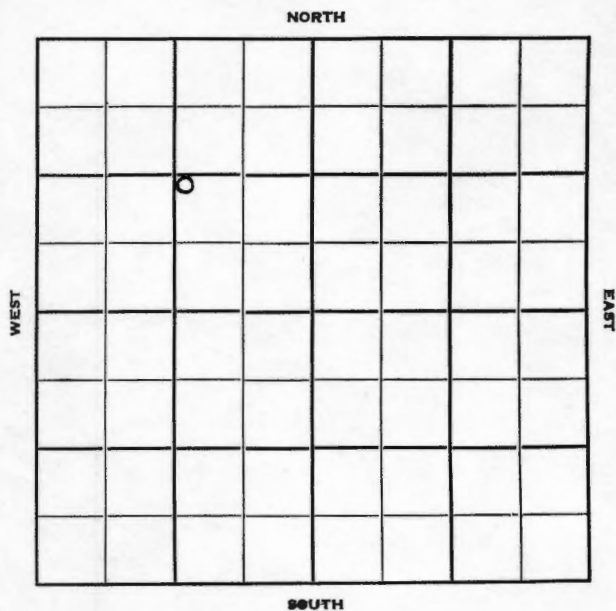


Section 24 Township 25 Range 38 WWell No. # 1 DaleCompany Stanolind

Kearny

KANSAS

Sec. 24 Twp. 25 R. 38 W

Well No. # 1 Dale Farm

Stanolind

Company

Contractor

Hugoton Pool


Ft. from N. Line

1250 Ft. from S. Line

1250 Ft. from E. Line

Ft. from W. Line

NW SE NW

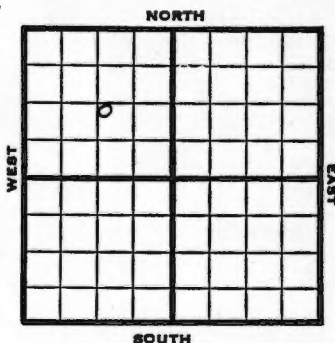

1951

Elev. 3109'

REPORT

5/23

Location

7/11

Spud 5-30-51 Gas well TD 2572'
 10" @ 544 7" @ 2526' TD 2572'
 Her. 2358' Win 2410' Ft Riley 2482'
 42/2366-73 42/2394-2401'
 108/2413-31' 30/2434-39'
 78/2488-2501' 18,250 A
 Comp. 17,885,000 gas

COMPLETED

J. E. TYRA

County **Kearny** State **Kansas**

Sec. **24** (Blk. Twp.) **25** (Sur. Rge.) **38W** Map No. _____

Operator **Stanolind**

Well No. 1 Farm Dale

Elev.	Location	NW	SE	NW
-------	----------	----	----	----

1250 Ft. From S Line NW

1250 Ft. From E Line Quarter

1st. Report MAY 23 1951

Completion

Remarks

Spudding Date _____

Drig. Data Hugoton Pool

Location _____

J. E. TYRA