


Section 17 Township 25 Range 38W

Well No. 1 May Beaty "D"

Company Stanolind Oil and Gas Comony

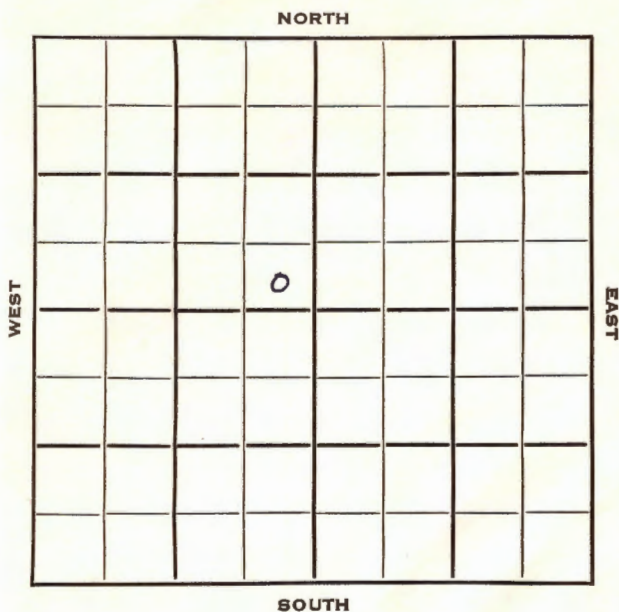

Kearny

KANSAS ✓

Sec. 17 Twp. 25 R. 38W

Well No. #1 May Beaty "D" Farm _____

Stanolind Company _____


Contractor _____

_____ Ft. from N. Line

400 Ft. from S. Line

400 Ft. from E. Line

_____ Ft. from W. Line

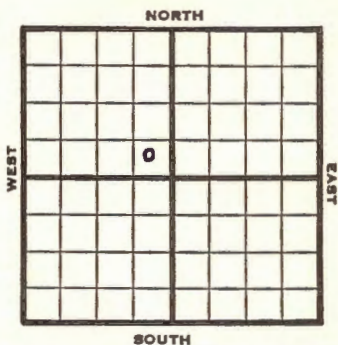

SE NW

1953 **Elev. 3143'** REPORT

1/14 Location

1/22 "

1/29 8" @ 531 **Her Kr. 2317' - Win. 2370'**
Tow 2439' Ft. Riley 2468'
 RTD 2504' Schl 5" @ 2468'

2/5 Testing

2/12 "

2/18 Spud 1-15-53

Gas well TD 2504' 8" @ 531 **Her-Kri**
2317' Win 2370' Towanda 2439'
Ft. Riley 2468' TD 2504'

5" @ 2468 CO to 2504 2500 A

12/2318-20 12/2325-27 12/2329-31

18/2333-36 12/2338-40 12/2342-44

30/2351-56 12/2360-62 36/2371-77

48/2383-91 42/2394-2401 12/2428-30

35/2455-60 78/2439-52 4000 A

Comp. 1,696,000 gas

COMPLETED

County Kearny State Kansas

Sec. 17 (Blk. Twp.) 25 (Sur. Rge.) 38W Map No.

Operator Stanolind

Well No. 1 Farm May Beaty "D"

Elev. 3143 Location SE NW



400 Ft. From S Line NW

400 Ft. From E Line Quarter

1st. Report

FEB 18 1953

Completion

Remarks

Spudding Date 1-15-53

Drlg. Data Gas well TD 2504

8" @ 531 Her-Kri. 2317 Win. 2370

Towanda 2439 Ft. Riley 2468 TD 2504

5" @ 2468 CO to 2504 2500 A 12/ 2318-20

12/ 2325-27 12/ 2329-31 18/ 2333-36

12/ 2338-40 12/ 2342-44 30/ 2351-56

12/ 2360-62 36/ 2371-77 48/ 2383-91

42/ 2394-2401 12/ 2428-30 35/ 2455-60

78/ 2439-52 4000 A

Comp. 1,696,000 gas