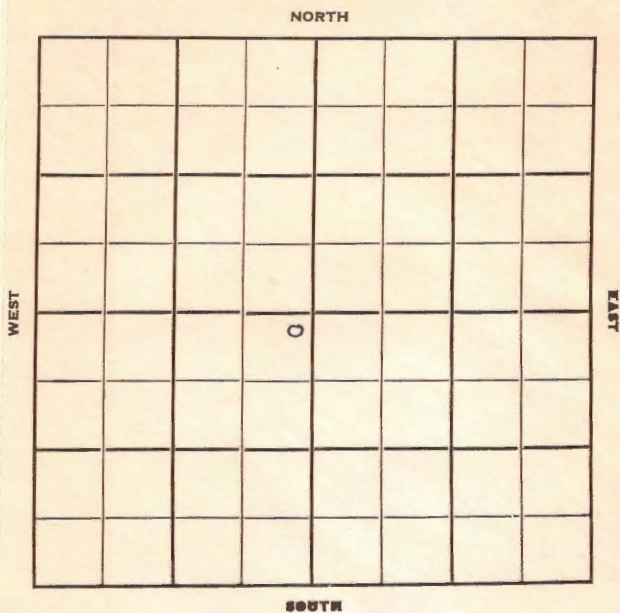


Section 28 Township 25 Range 38WWell No. #1 Max Cohen "A"Company Stanolind

Sec. 28 Twp. 25 R. 38W

Well No. #1 Max Cohen "A" Farm

Stanolind Company

Contractor

Hugoton Pool


150' Ft. from N. Line

Ft. from S. Line

150' Ft. from E. Line

Ft. from W. Line

NE SW

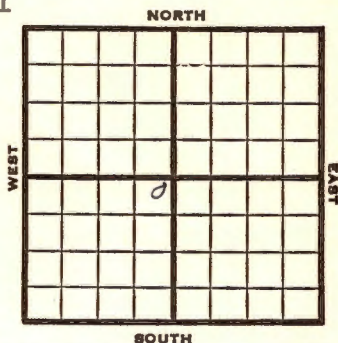

1951

Elev. 3171' REPORT

8/15

Location

9/26

Spud 9-1-51

Gas well TD 2588' 10" @ 566'

7" @ 2558' TD 2588' 60/2388-98

24/2402-06 24/2410-16 48/2426-34

60/2446-56 84/2464-78 48/2488-96

150/2512-38 Her. 2388' Win 2444'

Ft. Riley 2512' 24,500 A

Comp. 25,162,000 gas. 416#

COMPLETED



