

Section 30 Township 25 Range 38W

Well No. 1 Cleary

Company Stanolind Oil and Gas Company

NORTH

				0			

WEST

EAST

SOUTH

Sec. 30 Twp. 25 R. 38 W

Well No. # 1 Cleary Farm

Stanolind Company

Contractor


Ft. from N. Line

150 Ft. from S. Line

Ft. from E. Line

150 Ft. from W. Line

SW NE

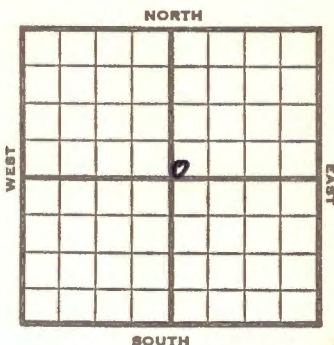

1953 **Elev. 3266'** REPORT

1/21 Location

1/29 "

2/5 "

2/12 "

2/19 8" @ 636'

2/26 RTD 2635 Lbc Log 5" @ 2611

**Her Kr 2451 Win 2497 op ft 2568
low ft. 2611**

3/12 NR

3/18 Spud 2-14-53 Gas well TD 2635'

8" @ 636 TD 3625 5" @ 2611

Her-Kri. 2451' Win. 2497 Ft. Riley

2568' CO to 2635 2500 A

60/2451-61 48/2465-73 24/2478-82

54/2497-2506 60/2509-19 30/2522-27

24/2529-39 24/2551-55 18/2557-60

36/2568-74 36/2576-82 36/2586-92

24/2594-98 32,000 A

Comp. 5,284,000 gas. 365#

COMPLETED

