


Section 24 Township 25 Range 39W

Well No. #1 USA

Company Thornbrough

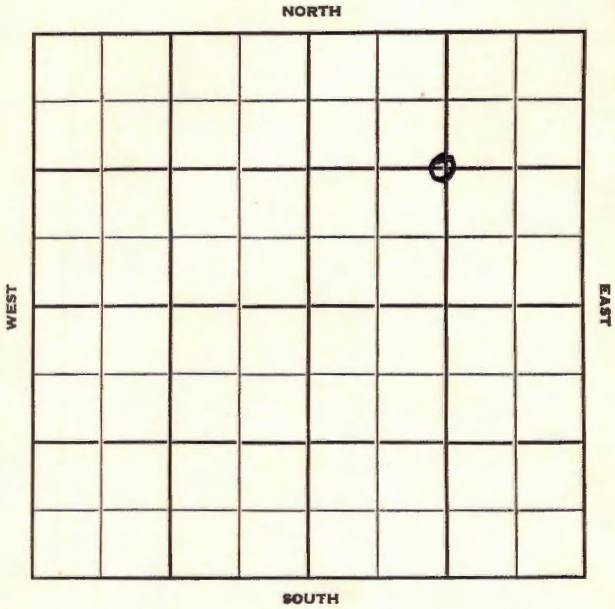

Hamilton KANSAS ✓

Sec. 24 Twp. 25 R. 39 W

Well No. # 1 U S A Farm

Thornbrough Company

Contractor


1320 Ft. from N. Line

Ft. from S. Line

1320 Ft. from E. Line

Ft. from W. Line

C NE/4

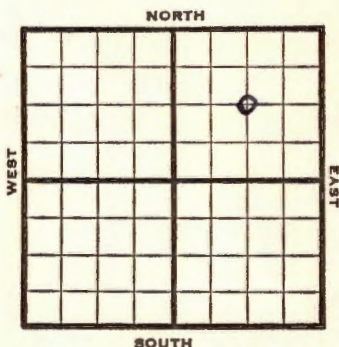

1952

Elev. 3204

REPORT

8/13

Spud 8-7-52
Drlg. 900'

8/20

RTD 2412 7" @ 2365
Her 2360 Krider 2372

8/27

NR

9/3

DD 2505

9/10

DD 2554 TD 2000 A Sq hole in pipe

9/17

NR

9/24

"

10/1

"

10/8

"

10/15

"

10/22

"

10/29

"

11/5

"

11/12

"

11/20

"

11/27

"

12/4

"

12/11

NR

12/18

NR

12/25

NR

OVER

1953

1/1 NR

1/8 NR

1/22 "

1/29 CO 2534' 23,000 A

2/5 NR

2/11 Spudding Date 8/7/52

Gas Well TD 2554

10" @ 297 Her. 2360 Kri. 2372


Win. 2414 Ft. Riley 2468 TD 2505

5" @ 2257 DD 2554 CO to 2534

23000 A Comp. 5,500,000 gas.

COMPLETED

County Hamilton State Kansas
 Sec. 24 (Blk.) 25 (Sur.) 39W Map No.
 Operator Thornbrough
 Well No. 1 Farm U S A
 Elev. 3204 Location C NE/4

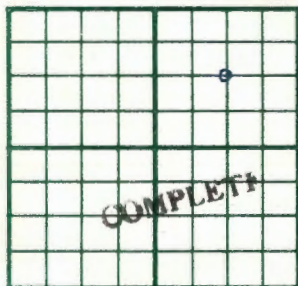

1320 Ft. From N Line NE
1320 Ft. From E Line Quarter

1st. Report


Completion FEB 11 1953

Remarks

Spudding Date 8-7-52

Drig. Data Gas well TD 2554
10" @ 297 Her. 2360 Kri. 2372
Win. 2414 Ft. Riley 2468 TD 2505
5" @ 2257 DD 2554 CO to 2534 23000 A
Comp. 5,500,000 gas

J. G. McGEHEE

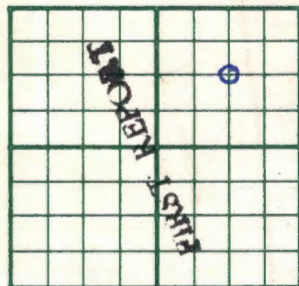County **Hamilton** State **Kansas**Sec. **24** (Blk. Twp.) **25** (Sur. Rge.) **39W** Map No.Operator **Thornbrough**Well No. **1** Farm **USA**Elev. Location **C NE/4****1320** Ft. From **N** Line **NE****1320** Ft. From **E** Line **Quarter**1st. Report **AUG 13 1952**

Completion

Remarks

Spudding Date **8-7-52**

Drig. Data

Drig. 900**J. G. McGEHEE**