


Section 36 Township 25 Range 39WWell No. #1 E. YinglingCompany United Prod.

NORTH

WEST

EAST

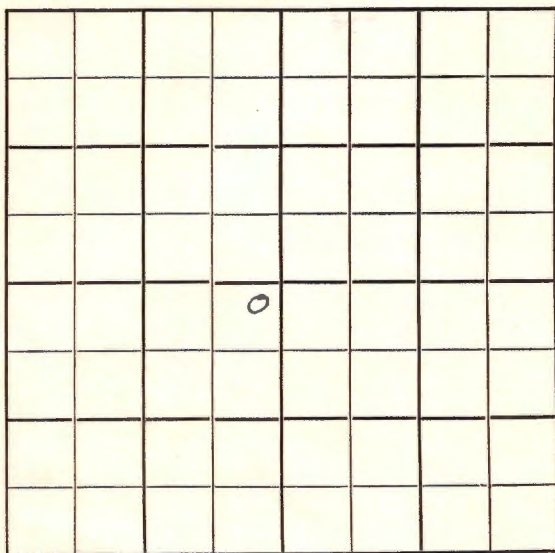

SOUTH

Hamilton

KANSAS

Sec. 36 Twp. 25 R. 39W ✓

Well No. #1 E. Yingling Farm

United Prod. Company

Bacco Drlg. - Contr. Contractor


150' Ft. from N. Line

Ft. from S. Line

150' Ft. from E. Line

Ft. from W. Line

NE SW

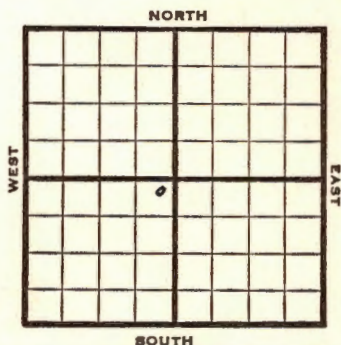

1950

Elev. 3287

REPORT

11/29

Location

1951

2/7

Spud 12/8/50

Gas well TD 2673

10" @347

Hol. 2420 Her. 2442 Krider 2458

Win. 2492 Ft. Riley 2558

TD 2673

7" @2648 12000 A

Comp. 1,575,000 gas 411#

COMPLETED

J. E. TYRA

County Hamilton State KansasSec. 36 (Blk.) 2 5 (Sur.) 39W Map No.Operator United Prod.Well No. 1 Farm E. YinglingElev. 3287 Location NE SW150 Ft. From N Line SW150 Ft. From E Line Quarter

1st. Report

Completion FEB 7 1951

Remarks

Bacco Drlg. - Contr.Spudding Date 12-8-50Drlg. Data Gas well TD 267310" @ 347 Hol. 2420 Her. 2442Krider 2458 Win. 2492 Ft. Riley 2558TD 2673 7" @ 2648 12000 AComp. 1,575,000 gas 411#

J. E. TYRA