


KANSAS Reno

Section 33 Township 25S Range 4W

Well No. #2 Cohen

Company Phillips

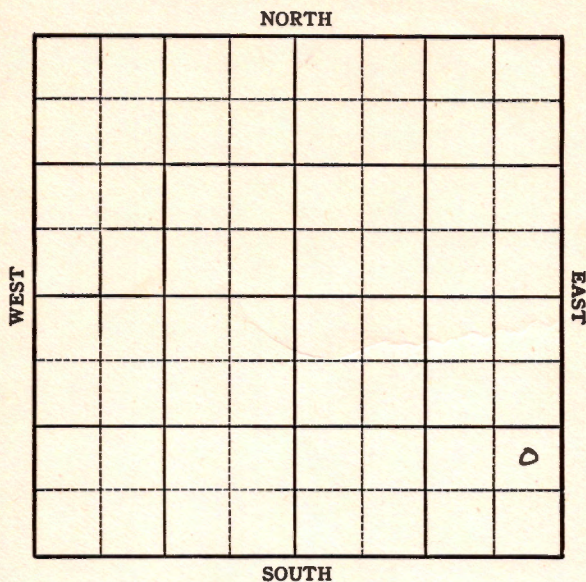

Sec. 33 Twp. 25 R. 4W


Well No. #2 Cohen Farm
Phillips Company
Hilgers Pool

_____ Ft. from N. Line

990' Ft. from S. Line

330' Ft. from E. Line

_____ Ft. from W. Line

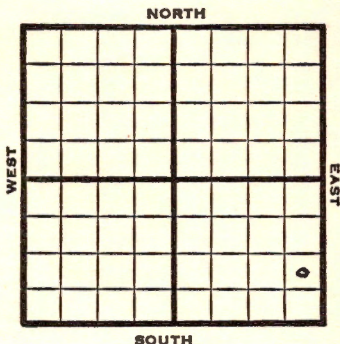

NE SE SE

1949 **Elev. 1542'** REPORT

9/14	Location
9/21	"
9/28	"
10/5	"
10/12	RUR
10/19	8" @ 338' Drlg 1645'
10/26	Drlg. 2375'
11/1	Drlg 4050'
11/9	Miss 3617' Misener 4066' Viola 4090' TD 4094- 5" @ 4088'
11/16	Swb 151 bbls oil 3 hrs.
11/23	"
11/29	"
12/7	"
12/14	Viola 4090' 5" @ 4088' Echo Pot. 1757 oil Gr. 42.7° TD 4094'

COMPLETED

Map No. _____ Sec. 33 Twp. 25 R. 4W

Well No. 2 Cohen

Phillips Company

Contractor

NE SE SE

SECTION PLAT

			◊

_____ Ft. from N. Line

990 Ft. from S. Line

330 Ft. from E. Line

_____ Ft. from W. Line

Reno County

RECORD

Location X

Cased _____ in., _____ ft.

Rig up _____

Sand _____

Drilling and Remarks:

Gas _____

Oil _____

Total Depth _____

PRODUCTION

1st 24 hrs. Nat. _____

1st 24 hrs. after shot _____

Gas _____ Cu. Ft.

Dry Hole _____

Abandoned _____

Date

SEP 14 1949

19

S. J. LEWIS

Scout

Map No. _____ Sec. 33 Twp. 25 R. 4W

Well No. 2 Cohen

Phillips Company

COMPLETE Contractor

NE SE SE

E. 11592
SECTION PLAT

_____ Ft. from N. Line

990 Ft. from S. Line

330 Ft. from E. Line

_____ Ft. from W. Line

			5

Reno County

Location _____

Rig up _____

Drilling and Remarks:

Viola 4090

5' C 4088

Echo 1257006

42 7/8

RECORD

Cased _____ in., _____ ft.

Sand _____

Gas _____

Oil _____

Total Depth 4094

PRODUCTION

1st 24 hrs. Nat. _____

1st 24 hrs. after shot _____

Gas _____ Cu. Ft.

Dry Hole _____

Abandoned _____

Date

DEC 14 1949

19

S. J. LEWIS

Scout