

Reno

KANSAS


O. W. P. B.

FORM 51 5M BR1X

Section 33 Township 25 Range 4W

Well No. #2, Colley

Company Phillips Pet. Co.

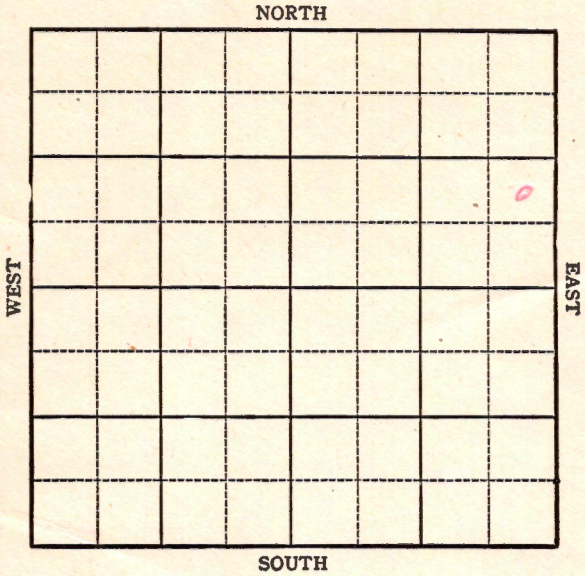

KANSAS

Reno


KANSAS

O. W. P. B.

Sec. 33 Twp. 25 R. 4W

Well No. #2, Colley Farm
Phillips Company

NORTH

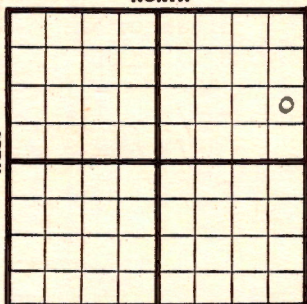

 Ft. from N. Line

990 Ft. from S. Line

330 Ft. from E. Line

 Ft. from W. Line

Elev. 1561

REPORT

1944

- 6/7 Rotary
- 6/15 15" @ 298
Drlg. 1055
- 6/21 Drlg. 3039
- 6/28 **Miss 3659**
Drlg 3816
- 7/12 **Viola 4110**
TD 4111
5" @ 4107
RUST
- 7/19 2140' oil plus 1180 W
- 7/26 " " " " "
- 8/2 Pump 68 oil plus 124 wtr in 8 hrs.
- 8/9 " " " " " " " "
- 8/16 " " " " " " " "
- 8/23 " " " " " " " W W W
- 8/30 " " " " " " " " "
- 9/6 **Viola 4110**
5" @ 4107
TD 4111
Pump 262 oil plus 262 water
Pot.
40.0 Gravity

COMPLETED OVER
O. W. P. B.

1953

#2 Cooley

3/11

Lans. 2873 Misener 4089 Viola 4110
OTD 4111 5" @ 4107 DC 4105 56/4090-
4104 B/4 gwph to SP

3/18

D & A TD 4111' Lans. 2873
Misener 4089 Viola 4110'
OTD 4111 5" @ 4107 DC to 4105'
56/4090-4104 B/4 GWPH PB 3335
71/3294-3303 B/47 GW 8 hr. SP 3290
24/3266-72 B/9½ GW 6 hr.

D & A

ABANDONED

O. W. P. B.

County Reno State KANSAS
 Sec. 33 (Blk. 25 (Sur. 4W (Twp.) Map No.)
 Operator Phillips Pet.
 Well No. 2 Farm Cooley
 Elev. 1561 Location NE SE NE



990 Ft. From S Line NE
 330 Ft. From E Line Quarter

1st. Report

Completion MAR 18 1953

Remarks

OWPB

O. W. P. B.

Spudding Date

Drig. Data D & A TD 4111Lans. 2873 Misener 4089 Viola 4110OTD 4111 5" @ 4107 DC to 4105 56/ 4090-4104 B/ 4 gwph PB 3335 71/ 3294-3303B/ 47 gw 8 hr. SP 3290 24/ 3266-72B/ 9½ gw 6 hr.D & A

J. G. McGEHEE