


Map No. KANSAS Sec. 17 Twp. 23 R. 71

Well No. 1-1000 Farm

Latlock & Shell Co. Company

NORTH Vernon-Shell et al

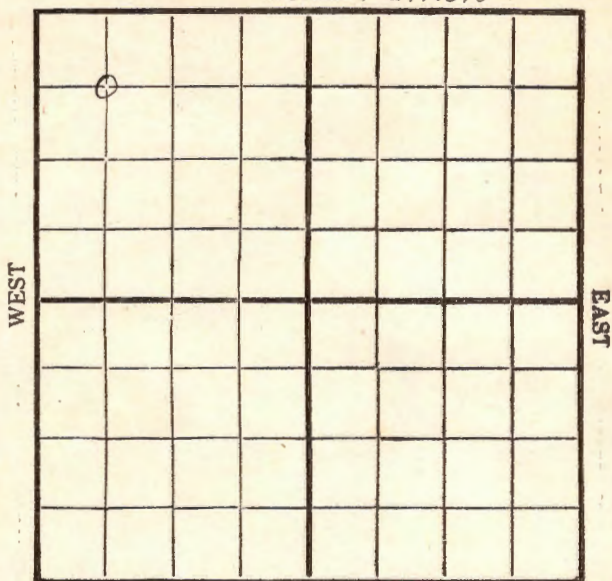

SOUTH

OWDD

Location _____

Drilling Remarks _____

Rig Up _____

Drilling Remarks _____

RECORD

Cased _____ in. _____ ft.

Sand _____

Gas _____

Oil _____

Total Depth _____

PRODUCTION

1st 24 hrs. Nat. _____

1st 24 hrs. after shot _____

Gas _____ cu. ft. _____

Dry Hole _____

Abandoned _____

Map No. KANSAS Sec. 17 Twp. 25 R. 4^w

Well No. 1 Tong Farm

~~Latlock & Shell Pet~~ Company


Vernon-Shell et al

660 Ft. from N. Line

_____ Ft. from S. Line

_____ Ft. from E. Line

660 Ft. from W. Line

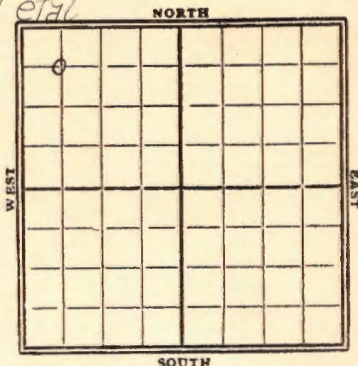

Date

REPORT

11/20 Location

11/27 cellar

12/4 Spud

12/11 50

12/18 —

12/23 —

12/30 —

1930

1/8 —

1/15 —

1/22 —

1/29 —

2/5 —

2/12 —

2/19 Rigging up.

2/26 Spud.

3/5 Hdg. 890'

3/12 " 975'

3/19 " 1785'

3/26 W/P 10" - 1975'

4/2 Hdg. 2320'

4/9 " 2805'

4/16 - U.R. 8" 3010'

4/23 - 3120 U.R. 8" -

27W - 3090

4/30 - U/R 8" 3195' -

5/7 - 8" 3226

hrlg 3276'

5/14 - " 3509'

5/21 - Top Chat 3532.

T.D. 3551' run 6"

5/28 - S.D. 3551'

6/4 —

6/10 - Top Chat 3605

T.D. 3611

Made 3 flows
Now have HF oil
Bldg storage

6/18 - T.D. 3611 -

Flowed through
2" tubing 231 bbls
oil 24 hrs. -
will test on pump.

6/25 - T.D. 3611'
Pumped 197½
bbls 18 hrs.

20% water.

7/2 - Chat 3605-11

TD 3611

Comp Pump 275 bbl oil
Comp Anal 30 " water

Map No. **KANSAS** Sec. 17 Twp. 25 R. 4W

Well No. 1 Town

Patton & Shell Pet Company

Contractor

SECTION PLAT

660 Ft. from N. Line

..... Ft. from S. Line

..... Ft. from E. Line

660 Ft. from W. Line

0			

FIRST REPORTS

Location ✓

Rig up

Drilling and Remarks:

RECORD

Cased in., ft.

Sand

Gas

Oil

Total Depth

PRODUCTION

1st 24 hrs. Nat.

1st 24 hrs. after shot

Gas Cu. Ft.

Dry Hole

Abandoned

Date

NOV 20 1929

S. J. LEWIS Scout

Map No. **KANSAS** Sec. 17 Twp. 25 R. 4W
 Well No. 40 1 Monn

Tattoo & Shell Pk. Company

Contractor

SECTION PLAT

0			

660 Ft. from N. Line

_____ Ft. from S. Line

_____ Ft. from E. Line

660 Ft. from W. Line

COMPLETED

RECORD

Location _____

Cased _____ in., _____ ft.

Rig up _____

Sand _____

Drilling and Remarks:

Gas _____

Chas. 2605-3611

Oil _____

Total Depth 3611

PRODUCTION

1st 24 hrs. Nat. _____

1st 24 hrs. after shot _____

Gas _____ Cu. Ft.

Dry Hole _____

Abandoned _____

Date

JUL 2 1930

S. J. LEWIS

Scout