

Reno

KANSAS

SECTION 14 TOWNSHIP 25 RANGE 4W

WELL NO. #1 Mount

COMPANY DeMeir Oil (Tulsa)

NORTH

0							

WEST

EAST

SOUTH

Reno

SEC.	TWP.	R.
14	25	4W

WELL NO.

#1 Mount

FARM

COMPANY

DeMeir Oil (Tulsa)

CONTRACTOR

Badger

WILDCAT


Ft. from N. Line

Ft. from S. Line

Ft. from E. Line

Ft. from W. Line

SW SW NW

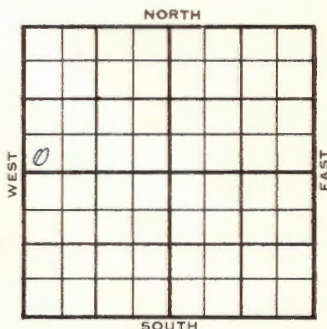

ELEVATION

REPORT

1956

1473' KB

5-2 Location

5-29 6 5/8" @ 230 w/200

DST 3925-4055 op 1 hr. rec. 285' SW,
BHP 1200#

D & A

H. 2518', BL. 2706', L. 2951',

M. 3528', K. 3894', Mz. 3991';

V. 4012', S. 4030'.

TD 4055'

ABANDONED

County Reno Elev. 1473 KB
 Sec. 14 Twp. 25 Rge. 4W
 Company DeMeir Oil (Tulsa)
 Farm Name Mount No. 1

TOPS	DEPTH	LOG	DATUM	Loc. in Sec.
Anh				SW SW NW
Tr.				
H.	2518			
Dg.				
Bl.	2706			
L.	2951		1472	Geol.
K.C.				
B.K.C.				Contr.
Ce.				Badger
C.				
M.	3528		2055	
M.				Pool
K.	3894		2421	
Mz.	3991		2512	Wildcat
Mq.				
V.	4012		2539	
S.	4030		2559	
S.				
A.				
R.				
Pe.				
G.				
ED	4055			

ABANDONED

Date Comm.

MAY 29 1956

Location

MAY 9 '56

85/8 230/200

11/1360

MAY 10 '56

11/3290

MAY 23 '56

11/4012

MAY 29 '56

DST 3925-4055 1 hr 285' SW

BHP 1200

D&A

County Reno Elev. _____
 Sec. 14 Twp. 25 Rge. 4W
 Company DeMeir Oil (Tulsa)
 Farm Name Mount No. 1

TOPS	DEPTH	LOG	DATUM	Loc. in Sec. _____
Anh.				SW SW NW
Tr.				
H.				
Dg.				
Bl.				Geol. _____
L.				
K.C.				
B.K.C.				
Ce.				Contr. <u>Badger</u>
C.				
M.				
M.				
K.				Pool <u>Wildcat</u>
Mz.				
Me.				
V.				
S.				0 FIRST REPORT MAY 2 '55
S.				
A.				
R.				
Pe.				
G.				
T.D.				

Date Comm. _____

Location _____

MAY 2 1955

L.C.

238